

MARSHALL
X 8
12-15-71

MISSISSIPPI
 BOARD OF WATER COMMISSIONERS
 416 North State Street
 Jackson, Mississippi 39201

CODED

WATER WELL DRILLERS LOG

12/15/1971 G. and H. Well Co. Marshal
 date well completed firm name county well located

LANDOWNER:	description of formations encountered	from	to
G. D. Thomas Route 1 Box 64, Waterford, Mississippi (mailing address)			
WELL LOCATION: sec. 9 T 6 N R 2 E 7 miles SE of Waterford (distance) (direction) (nearest town)	Red Sand	15	30
	" "	30	40
	Clay	40	50
	" Rock (Omented)	50	60
	# Sand & Pea	60	70
	" Gravel 3 inches	70	80
	Line Sand, White, & Mixture	80	90
	"	90	100
	"	100	110
	"	110	120
"	120	126	
WELL PURPOSE: Home (home, irrigation, municipal, industrial)			
WELL COMPLETION DATA:			
(1) diameter (inches) 4 IN			
(2) total depth (feet) 126			
(3) static water level (feet) 80 below above top of ground.			
(4) casing 4 IN 126 (material) (depth)			
(size) If telescope see back.			
(5) screen 5 FT. 5 FT. (length) (depth to top)			
4 In. Gravel (size) (material)			
(6) pump 3/4 18 GPM (HP) (yield gpm)			
Eleetric (type power)			
(7) electric log No (yes or no)			
(organization running log)			
Cap			
(8) how well bottom plugged			

CODED


JAN 13 1972

MISS. BD. OF WATER COMM.

DRILLERS REMARKS:

If well telescopes please sketch and show depths.

GROUND LEVEL

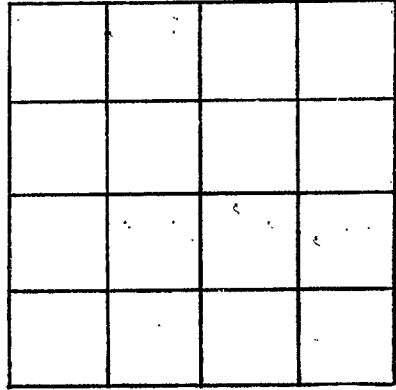

SECTION _____

Please indicate well location X.

ADDITIONAL INFORMATION

Lined area for additional information, consisting of 18 horizontal lines.

If more than one screen, show locations of each on sketch.