

MARSHALL
 X9
 1-20-73

MISSISSIPPI
 BOARD OF WATER COMMISSIONERS
 416 North State Street
 Jackson, Mississippi 39201

110000
 CODED
 110000
 110000
 Marshall
 Fayetteville

WATER WELL DRILLERS LOG

120 1973 J Medlin
 date well completed firm name county well located

LANDOWNER: Frank
 Morris
 Foltscamp
 (mailing address)

description of formations encountered	from	to
mixed clay	0	200
blue clay	210	560
rock + sand	560	620

WELL LOCATION:
 sec. 1 T 6 N R 2 E
 (distance) miles (direction) of (nearest town)

WELL PURPOSE:
 (home, irrigation, municipal, industrial)

- WELL COMPLETION DATA:
- (1) diameter (inches) 4
 - (2) total depth (feet) 620
 - (3) static water level (feet) 6 below top of ground
 - (4) casing (material) P (depth) 270
 - (size) If telescope see back.
 - (5) screen (length) 0 (depth to top)
 - (size) (material)
 - (6) pump (HP) (yield gpm)
 - (type power)
 - (7) electric log (yes or no)
 - (organization running log)
 - (8) how well bottom plugged Open

COUNTY


FFR 5 1973

DRILLERS REMARKS:

MISSISSIPPI
 BOARD OF WATER COMMISSIONERS
 JACKSON, MISSISSIPPI

If well telescopes please sketch and show depths.

GROUND LEVEL

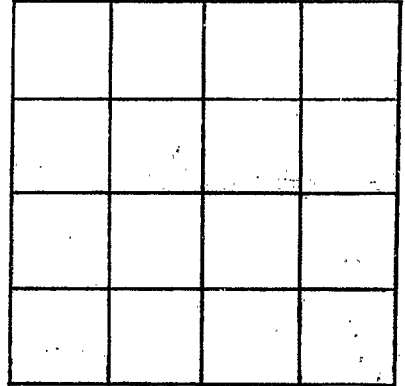

SECTION _____

Please indicate well location X.

ADDITIONAL INFORMATION

If more than one screen, show locations of each on sketch.