

Marshall  
X  
2001

MISSISSIPPI  
 BOARD OF WATER COMMISSIONERS  
 416 North State Street  
 Jackson, Mississippi 39201

WATER WELL DRILLERS LOG

9-3-81 1981 J.T. Miller Marshall  
 date well completed firm name county well located

LANDOWNER: Oliver Lyles  
Potts Camp MS,  
 (mailing address)

description of formations encountered	from	to
<u>sand &amp; Rock</u>	<u>0</u>	<u>240</u>
<u>Clay &amp; Rock</u>	<u>230</u>	<u>488</u>
<u>Clay &amp; Sandstone</u>	<u>488</u>	<u>670</u>
<u>Clay &amp; sand</u> <u>Rock</u>	<u>690</u>	<u>800</u>

WELL LOCATION:  
 sec 18 T 6 N R 2 E  
6 miles S-W of POTT'S CAMP  
 (distance) (direction) (nearest town)

WELL PURPOSE:  
 (home, irrigation, municipal, industrial)

- WELL COMPLETION DATA:
- (1) diameter (inches) 4
  - (2) total depth (feet) 800
  - (3) static water level (feet) 410 <sup>below</sup> <sub>above</sub> top of ground.
  - (4) casing PVC 400'  
 (material) (depth)  
 (size) If telescope see back.
  - (5) screen \_\_\_\_\_ (length) \_\_\_\_\_ (depth to top)  
 (size) \_\_\_\_\_ (material)
  - (6) pump 1/2 10  
 (HP) (yield gpm)  
Ele  
 (type power)
  - (7) electric log \_\_\_\_\_ (yes or no)  
 (organization running log)
  - (8) how well bottom plugged \_\_\_\_\_

DRILLERS REMARKS:


DEPT. OF NATURAL RESOURCES  
 BUREAU OF LAND & WATER RESOURCES

MAR 15 1982

RECEIVED

If well telescopes please sketch and show depths.

GROUND LEVEL

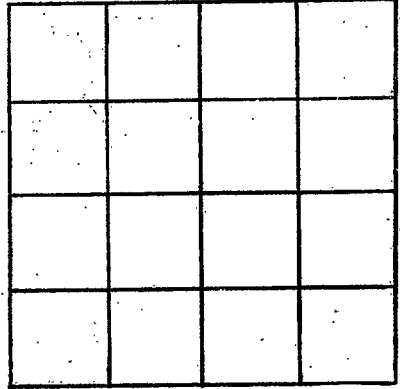

SECTION \_\_\_\_\_

Please indicate well location X.

ADDITIONAL INFORMATION

If more than one screen,  
show locations of each on sketch.