

MISSISSIPPI DEPARTMENT OF NATURAL RESOURCES

Bureau of Land and Water Resources

Southport Mall

P.O. Box 10631

Jackson, Mississippi 39209

WATER WELL DRILLERS LOG

Marshall
X 2002

7.6 19 *83* *Medlin* *Marshall*
 date well completed firm name county well located

LANDOWNER:	description of formations encountered	from	to
<i>Mrs R. H. Pottan</i>	<i>Clay</i>	<i>0</i>	<i>265</i>
<i>Dotta Camp</i> (mailing address)	<i>Limestone</i>	<i>265</i>	<i>480</i>
WELL LOCATION: sec. <i>6</i> T. <i>6</i> N. R. <i>2</i> E <i>6</i> miles <i>SW</i> of <i>P.C.</i> (distance) (direction) (nearest town)	<i>Shell + Blue clay</i>	<i>480</i>	<i>520</i>
WELL PURPOSE: (home, irrigation, municipal, industrial)	<i>Arquian + Shell</i>	<i>520</i>	<i>680</i>
WELL COMPLETION DATA:			
(1) diameter (inches) <i>4</i>			
(2) total depth (feet) <i>680</i>			
(3) static water level (feet) <i>90</i> below above top of ground.			
(4) casing <i>PVC</i> <i>380</i> (material) (depth)			
(size) If telescope see back.			
(5) screen (length) (depth to top)			
(size) (material)			
(6) pump <i>1/2</i> <i>17</i> (HP) (yield gpm)			
<i>Elac.</i> (type power)			
(7) electric log (yes or no)			
(organization running log)			
(8) how well bottom plugged <i>0</i>			
DRILLERS REMARKS:			


DEPT. OF NATURAL RESOURCES
 BUREAU OF LAND & WATER RESOURCES

AUG 4 1983

RECEIVED

If well telescopes please sketch and show depths.

GROUND LEVEL

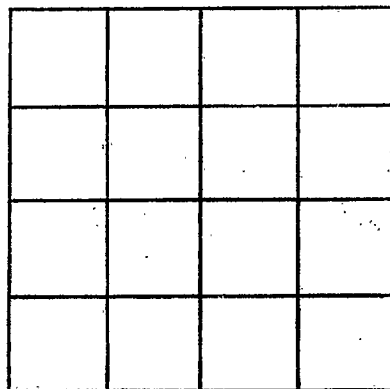

SECTION _____

Please indicate well location X.

ADDITIONAL INFORMATION

If more than one screen,
show locations of each on sketch.