

MISSISSIPPI DEPARTMENT OF ENVIRONMENTAL QUALITY

Office of Land and Water Resources

P. O. Box 10631
Jackson, MS 39289-0631
WATER WELL DRILLERS LOG

COUNTY WELL LOCATED MARSHALL	
WELL NUMBER X 2003	CODED
DATE WELL COMPLETED Sept 1994	

PERMIT NUMBER
NAME OF DRILLING FIRM Zeeper Drilling
Port to tie

NAME & MAILING ADDRESS OF LANDOWNER Jackie Swords
ECRU, MS

WELL LOCATION: SEC 6 TOWNSHIP 6 RANGE 2
N S E W

DISTANCE 14 Miles	DIRECTION SW	NEAREST TOWN Holly Springs
--------------------------	---------------------	-----------------------------------

OTHER LANDMARK
WELL PURPOSE: Home, Irrigation, Municipal, Industrial, Fish Pond, etc. Deer Camp

PUMP DATA

PUMP TYPE (Circle One): <u>Submersible</u> Turbine, Jet, Flowing Well, Other (Describe)

POWER TYPE (Circle One): <u>Electric</u> Tractor, Diesel, Gasoline, Butane, Other (Describe) H/P 3/4

Pump Capacity (GPM) 10	No. of Stages 11	Setting Depth 160' FT.
-------------------------------	-------------------------	-------------------------------

PUMP TEST
Well yielded _____ GPM with a drawdown of _____ ft. after _____ hours of pumping

WELL DATA

Well Depth 300'	Casing Diameter (In.) 4"	Casing Length (Ft.) 220'
Type of Casing PVC	Hole Depth 300'	Depth to Static Water Level 100'

TYPE OF COMPLETION: (Circle One or More): Gravel Packed, Underreamed, Telescoped, Natural Development, <u>Open Hole</u> , Other (Describe)

WELL GROUTED TO A DEPTH OF _____ FEET Type Grout (circle one): Cement, Bentonite, or Mix

SCREEN DATA

Diameter - Inches	Length - Feet	Slot Size - Inches
Screen Type	Depth to Bottom - Feet	

LOG DATA

TYPE OF LOG RUN (Circle One): Electric, Gamma Ray, Density, Sonic, Neutron, Other (Describe)	No Log Run
--	------------

Name of Organization Running Log

GEOLOGIC DATA (Office Use Only)

Surface Elev.	Geologic Unit	Unit Thickness	Depth to Top'
Subs. SWL	Date	Analysis	Aquifer Test


Driller's Remarks

DESCRIPTION OF FORMATIONS ENCOUNTERED	FROM	TO	FORMATIONS (Continued)	FROM	TO
TOP Clay	0	20	DEC 11 1995 Dept of Environmental Quality Office of Land and Water Resources		
Blue Clay	20	140			
Silt Silty Sand	140	260			
fine Sand	260	300			

IF MORE SPACE IS NEEDED, USE BACK

If well telescopes please sketch and show depths.

GROUND LEVEL

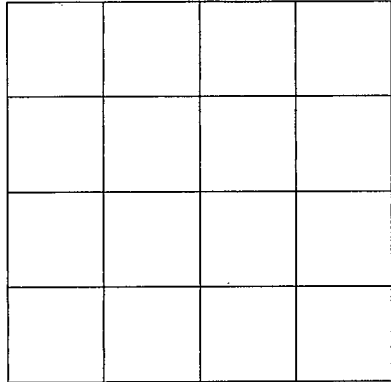

SECTION _____

Please indicate well location X.

ADDITIONAL INFORMATION

If more than one screen,
show location of each on sketch.