

Y12

CODED

8-29-60

WATER WELL DRILLERS LOG

Date: 8-29, 1960, Driller: J. L. Wadley County Marshall
 (Name)


(1) Owner of Land: A. A. Lemons
 (Name)
Potts Camp R. 2 D 1
 (Address)
W 30 1/2, NW 1/4, Sec. 16 T. 1 R. 1
 (2) Location:
7 1/2 miles South of Potts Camp
 (distance) (direction) (Nearest Town)
 (3) Topography: _____
 (Hilly) (Flat) (Level)
 (4) Purpose of Well: _____
 (Domestic Irrigation
 Municipal, Industrial, Other)

Description & Color of Materials Sand, Clay, Red Clay, Shell, etc.	Thick- ness Feet	Depth Feet
<u>soil & clay</u>	<u>30</u>	<u>30</u>
<u>sand mixed with</u>		
<u>heavy formation</u>	<u>178</u>	<u>200</u>
<u>blue shale</u>	<u>340</u>	<u>550</u>
<u>rock & sand</u>	<u>20</u>	<u>570</u>
<u>blue sand</u>	<u>60</u>	<u>630</u>
<u>rock & sand</u>	<u>75</u>	<u>705</u>

Information upon completion of well:

(1) Diameter 4 inches.
 (2) Total Depth 700 feet.
 (3) Water Level Artesian feet below top of ground.
 (4) Cased to 202, Size _____
 (5) Screen: Size _____, Length _____
 (6) Were any formations sealed against pollution?
 _____ yes, _____ no.

CODED

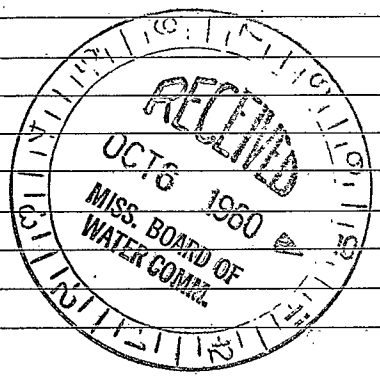

If YES depth of formation _____
 Why _____
 Drillers Remarks: _____

(Use Back Side)

Well No. 1300

