

15F

CODED

CODED

Marshall  
Y 15  
1-20-69

MISSISSIPPI  
BOARD OF WATER COMMISSIONERS  
416 North State Street  
Jackson, Mississippi 39201  
WATER WELL DRILLERS LOG

Jan. 20 19 69 J. W. Welch & Sons Marshall  
date well completed firm name county well located

LANDOWNER: Salem  
Baptist Church  
Cornersville, Miss  
(mailing address)

description of formations encountered	from	to
Clay	0	30
Clay & sand	30	70
sand	70	110
clay & sand	110	170
Blue Rock	170	500
sandy Blue Rock	500	615
water sand	615	730
Blue Rock	730	740

WELL LOCATION:  
sec 22 T. 6 N R. 1 W  
S W  
4 miles NW of Cornersville  
(distance) (direction) (nearest town)

WELL PURPOSE: home  
(home, irrigation, municipal, industrial)

WELL COMPLETION DATA:

- (1) diameter (inches) 4
- (2) total depth (feet) 740
- (3) static water level (feet) 40 below top of ground.
- (4) casing steel, 189' (material), (depth)
- (size) if telescope see back.
- (5) screen none (length), (depth to top)
- (size) (material)
- (6) pump 1/2 (HP), 6 (yield gpm)
- electric (type power)
- (7) electric log no (yes or no)
- (organization running log)
- (8) how well bottom plugged pipe.


CODED

MISS. BD. OF  
WATER COMM.

DRILLERS REMARKS:

If well telescopes please sketch and show depths.

GROUND LEVEL

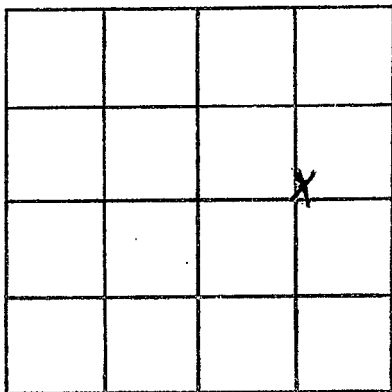

SECTION 22

Please indicate well location X.

ADDITIONAL INFORMATION

If more than one screen, show locations of each on sketch.