

MARSHALL

Y 16

11-26-69

MISSISSIPPI
 BOARD OF WATER COMMISSIONERS
 416 North State Street
 Jackson, Mississippi 39201

CODED

WATER WELL DRILLERS LOG

NOV 26

1969

J. W. Webb & Sons

firm name

Marshall

county well located

LANDOWNER: James Stark

description of formations encountered

from

to

Potts Camp Miss.
(mailing address)

Soil	0	21
Sand & Gravel	21	300
Blue Rock	300	710
Water-sand	710	820

WELL LOCATION:

sec. 7 T. 65 N R. 1 E
 S W
 1/2 miles West of Bethel
 (distance) (direction) (nearest town)

WELL PURPOSE:

(home, irrigation, municipal, industrial)

WELL COMPLETION DATA:

- (1) diameter (inches) 4
- (2) total depth (feet) 820
- (3) static water level (feet) 105' below top of ground.
- (4) casing Steel 3 1/2" (material), (depth)
 4 (size) if telescope see back.
- (5) screen (length) (depth to top)
 (size) (material)
- (6) pump 1/2 HP 7 (HP) (yield gpm)
 Ecoloc (type power)
- (7) electric log (yes or no)
 (organization running log)
- (8) how well bottom plugged


DEC - 8 1969

MISS. BD. OF WATER COMM.

DRILLERS REMARKS:

If well telescopes please sketch and show depths.

GROUND LEVEL

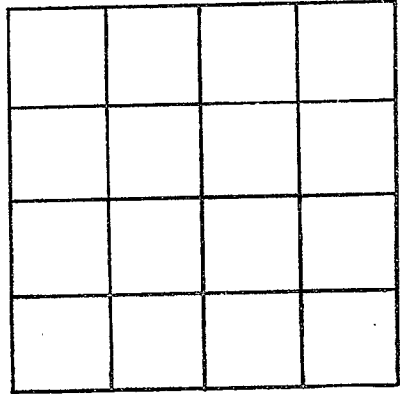

SECTION _____

Please indicate well location X.

ADDITIONAL INFORMATION

If more than one screen, show locations of each on sketch.