

Marshall  
Y-20  
8-13-71

MISSISSIPPI  
BOARD OF WATER COMMISSIONERS  
416 North State Street  
Jackson, Mississippi 39201

**CODED**

WATER WELL DRILLERS LOG

Aug 13 1971 Ed Clark Con. Marshall  
date well completed firm name county well located

LANDOWNER:

J. T. Sarrett  
Potts Camp, MS  
(mailing address)

description of formations encountered

from to

Sand	0	200
Blue mud	200	680
Rock, Sand & water	680	790

WELL LOCATION:

sec. 6 T. 6 N R. 1 E  
5 miles SE of Potts Camp  
(distance) (direction) (nearest town)

WELL PURPOSE:

Home  
(home, irrigation, municipal, industrial)

WELL COMPLETION DATA:

- (1) diameter (inches) 4"
- (2) total depth (feet) 790'
- (3) static water level (feet) 115' below top of ground.
- (4) casing metal, #3/8" (material) (depth) 4' if telescope see back.
- (5) screen None (length) (depth to top)
- (6) pump Rod 5 (HP) (material) (yield gpm)  
Electric (type power)
- (7) electric log No (yes or no)

**CODED**

SEP 16 1971

(organization running log)


(8) how well bottom plugged No

DRILLERS REMARKS:

MISS. BD. OF  
WATER COMMISSIONERS  
300 SOUTH MAIN ST.  
JACKSON, MISS. 39201

If well telescopes please sketch and show depths.

GROUND LEVEL

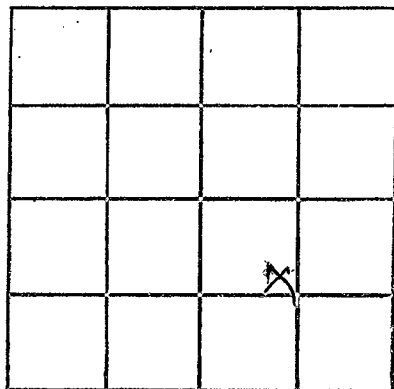

SECTION \_\_\_\_\_

Please indicate well location X.

ADDITIONAL INFORMATION

If more than one screen,  
show locations of each on sketch.