

Marshall
721
 7-69

WATER WELL DRILLERS LOG

CODED

Date: July 15, 1966, Driller: Johnny Webb County Marshall
 (Name)

(1) Owner of Land: J. M. Byers
 (Name)
cornersville, Miss.
 (Address)

(2) Location: 1/4, 1/4, Sec. 24 T6S R1W
3 miles N. E. of cornersville
 (distance) (direction) (Nearest Town)

(3) Topography: X
 (Hilly) (Flat) (Level)

(4) Purpose of Well: Domestic
 (Domestic Irrigation
 Municipal, Industrial, Other)

Description & Color of Materials Sand, Clay, Red Clay, Shell, etc.	Thick- ness Feet	Depth Feet
<u>Clay</u>	<u>0</u>	<u>30</u>
<u>sand & clay</u>	<u>30</u>	<u>100</u>
<u>sand</u>	<u>100</u>	<u>140</u>
<u>sand & clay</u>	<u>140</u>	<u>170</u>
<u>Blue marl</u>	<u>170</u>	<u>500</u>
<u>Water Sand</u>	<u>500</u>	<u>630</u>

Information upon completion of well:

(1) Diameter 4 inches.

(2) Total Depth 630 feet.

(3) Water Level 100 feet below top of ground.

(4) Cased to 193', Size 4"

(5) Screen: Size _____, Length _____.


(6) Were any formations sealed against pollution?
 _____ yes, _____ no.

CODED

If YES depth of formation _____

Why _____

Drillers Remarks: _____

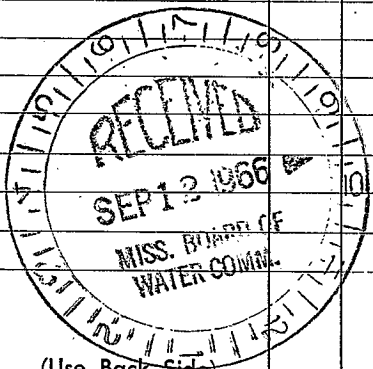

Retain this copy for your office files.

Well No.

(Use Back Side)

1894



1894