

MARSHALL

Y 24

8-72

CODED

MISSISSIPPI BOARD OF WATER COMMISSIONERS  
416 North State Street  
Jackson, Mississippi 39201

EX 788' 50"  
34' 20" FAX  
41819.00

WATER WELL DRILLERS LOG

19 J. T. Medlin date well completed firm name  
Marshall county well located


LANDOWNER: <u>Robert R. Wren</u>	description of formations encountered	from	to
<u>Hickory Flat</u> (mailing address)	<u>Clay</u>	0	20
WELL LOCATION: sec. <u>14</u> T. <u>6</u> N. R. <u>1</u> E. <u>W</u>	<u>sand</u>	20	50
<u>3</u> miles <u>East</u> of <u>Cornersville</u> (distance) (direction) (nearest town)	<u>sand &amp; clay mixed</u>	30	90
WELL PURPOSE: (home, irrigation, municipal, industrial)	<u>Blue clay</u>	80	560
WELL COMPLETION DATA:	<u>sand</u>	560	610
(1) diameter (inches) <u>4"</u>			
(2) total depth (feet) <u>610</u>			
(3) static water level (feet) <u>25'</u> <u>below</u> top of ground.			
(4) casing <u>Plastic</u> <u>116"</u> (material) (depth)			
_____ if telescope see back. (size)			
(5) screen <u>0</u> (length) (depth to top)			
_____ (size) _____ (material)			
(6) pump _____ (HP) _____ (yield gpm)			
_____ (type power)			
(7) electric log _____ (yes or no)			
_____ (organization running log)			
(8) how well bottom plugged _____			
DRILLERS REMARKS: <u>DOWN R.O.M.</u>			

AUG 22 1978

MISS. Bd. OF WATER COMMISSIONERS

If well telescopes please  
sketch and show depths.

GROUND LEVEL

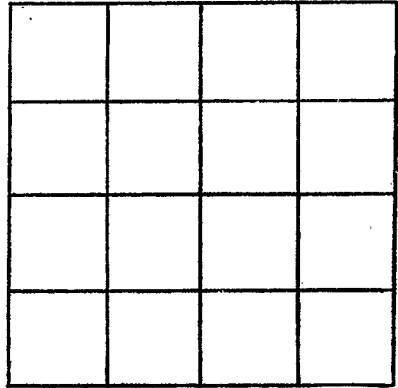

SECTION \_\_\_\_\_

Please indicate well location X.

ADDITIONAL INFORMATION

If more than one screen,  
show locations of each on sketch.