

MARSHALL
Y26
4-25-74

MISSISSIPPI
 BOARD OF WATER COMMISSIONERS
 416 North State Street
 Jackson, Mississippi 39201


WATER WELL DRILLERS LOG

4-25 1974
 date well completed

JT Martin
 firm name

Marshall
 county well located


LANDOWNER: <u>Raymond Smith</u>	description of formations encountered	from	to
<u>Star Rt Hickory Flat</u> (mailing address)	<u>black clay</u> <u>yellow clay</u> <u>rock & sand</u>	<u>0</u> <u>45</u> <u>790</u>	<u>45</u> <u>490</u> <u>610</u>
WELL LOCATION:			
sec <u>26 T 6 N</u> <u>R 1 E</u> <u>1</u> miles <u>W</u> of <u>Cornersville</u> (distance) (direction) (nearest town)			
WELL PURPOSE: (home, irrigation, municipal, industrial)			
WELL COMPLETION DATA:			
(1) diameter (inches) <u>7</u>			
(2) total depth (feet) <u>610</u>			
(3) static water level (feet) <u>6</u> <u>below</u> top of ground.			
(4) casing <u>P</u> <u>80</u> (material) (depth)			
<u> </u> If telescope see back. (size)			
(5) screen <u>0</u> <u> </u> (length) (depth to top)			
<u> </u> (size) <u> </u> (material)			
(6) pump <u>1/2</u> <u>10</u> (HP) (yield gpm)			
<u>E</u> (type power)			
(7) electric log <u> </u> (yes or no)			
<u> </u> (organization running log)			
(8) how well bottom plugged <u> </u>			
DRILLERS REMARKS:			

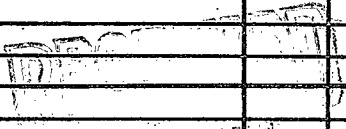

APR 30 1974

If well telescopes please sketch and show depths.

GROUND LEVEL

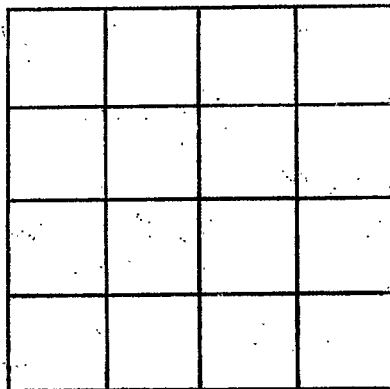

SECTION _____

Please indicate well location X.

ADDITIONAL INFORMATION

If more than one screen, show locations of each on sketch.