

MARSHALL  
Y 27  
7-22-74

MISSISSIPPI  
BOARD OF WATER COMMISSIONERS  
416 North State Street  
Jackson, Mississippi 39201

CODED

WATER WELL DRILLERS LOG

July 22, 1974 J. W. Wilby & Sons Marshall  
date well completed firm name county well located

LANDOWNER: Charles Williams

description of formations encountered	from	to
Soil	0	1
Sand & clay	1	169
Blue Rock	169	436
Water Rock & sand	436	548
Replay sand		

Hickory Flat Rt 2  
(mailing address)

WELL LOCATION:  
sec. 11 T. 6 N R. 16 E  
2 1/2 miles north E of Corns Mills  
(distance) (direction) (nearest town)

WELL PURPOSE:  
(home, irrigation, municipal, industrial)

WELL COMPLETION DATA:

- (1) diameter (inches) 4"
- (2) total depth (feet) 540
- (3) static water level (feet) 111 below top of ground.
- (4) casing steel 180 ft (material) (depth)  
4" (size) if telescope see back.
- (5) screen 0 (length) 0 (depth to top)  
(size) (material)
- (6) pump 1/2 HP 8 (HP) (yield gpm)  
Ede (type power)
- (7) electric log (yes or no)  
(organization running log)
- (8) how well bottom plugged

CODED


RECEIVED  
JULY 28 1974

DRILLERS REMARKS:

MISS. BD. OF WATER COMMISSIONERS

If well telescopes please sketch and show depths.

GROUND LEVEL

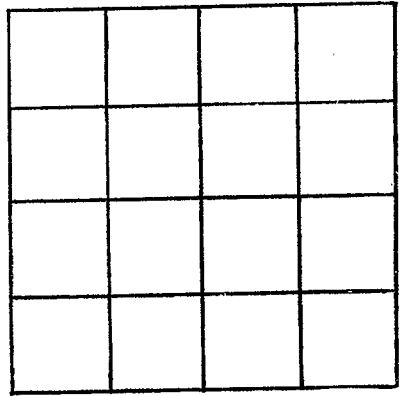

SECTION \_\_\_\_\_

Please indicate well location X.

ADDITIONAL INFORMATION

If more than one screen, show locations of each on sketch.