

MISSISSIPPI DEPARTMENT OF ENVIRONMENTAL QUALITY
Bureau of Land and Water Resources

P. O. Box 10631
Jackson, MS 39289-0631
WATER WELL DRILLERS LOG

COUNTY WELL LOCATED <i>Marshall</i>		
WELL NUMBER <i>Y32</i>	CODED <input checked="" type="checkbox"/>	PERMIT NUMBER
DATE WELL COMPLETED <i>Jan 1991</i>		NAME OF DRILLING FIRM <i>ZEEPER Drilling Pottscamp MS</i>

NAME & MAILING ADDRESS OF LANDOWNER <i>Kirby Gregg Hiway 349 RFD Potts Camp MS</i>		
WELL LOCATION: SEC	TOWNSHIP	RANGE
<i>22</i>	<i>6</i> ^N _S	<i>1</i> ^E _W
DISTANCE	DIRECTION	NEAREST TOWN
Miles _____	of _____	
OTHER LANDMARK <i>Behind Salem Church</i>		
WELL PURPOSE: Home, Irrigation, Municipal, Industrial, Fish Pond, etc. <i>Home</i>		

PUMP DATA		
PUMP TYPE (Circle One): <u>Submersible</u> Turbine, Jet, Flowing Well, Other (Describe) _____		
POWER TYPE (Circle One): <u>Electric</u> Tractor, Diesel, Gasoline, Butane, Other (Describe) _____ H/P _____		
Pump Capacity (GPM) <i>10</i>	No. of Stages <i>11</i>	Setting Depth <i>130</i> FT.
PUMP TEST		
Well yielded _____ GPM with a drawdown of _____ ft. after _____ hours of pumping		

WELL DATA		
Well Depth <i>625</i>	Casing Diameter (In.) <i>4"</i>	Casing Length (Ft.) <i>300</i>
Type of Casing <i>Pvc</i>	Hole Depth <i>625'</i>	Depth to Static Water Level <i>60'</i>
TYPE OF COMPLETION: (Circle One or More): Gravel Packed, Underreamed, <u>Telescoped</u> , Natural Development, Open Hole, Other (Describe) _____		
Top of Lap Pipe or Reduction in Casing		
FEET IF TELESCOPED OR MORE THAN ONE SCREEN: USE BACK PAGE		

LOG DATA	
TYPE OF LOG RUN (Circle One): No Log Run, Electric, Gamma Ray, Density, Sonic, Neutron, Other (Describe) _____	
Name of Organization Running Log	

SCREEN DATA		
Diameter - Inches <i>2"</i>	Length - Feet <i>40'</i>	Slot Size - Inches <i>1010</i>
Screen Type <i>Slotted Pvc</i>		Depth to Bottom - Feet <i>425'</i>


GEOLOGIC DATA (Office Use Only)			
Surface Elev.	Geologic Unit	Unit Thickness	Depth to Top
Subs. SWL	Date	Analysis	Aquifer Test
Driller's Remarks <i>4' x 2" Well</i>			

DESCRIPTION OF FORMATIONS ENCOUNTERED	FROM	TO
<i>Top Clay</i>	<i>0</i>	<i>20</i>
<i>Blue clay</i>	<i>20</i>	<i>60</i>
<i>fine sand</i>	<i>60</i>	<i>120</i>
<i>Shale</i>	<i>120</i>	<i>400</i>
<i>Chalk</i>	<i>400</i>	<i>585</i>
<i>Sand</i>	<i>585</i>	<i>625</i>

FORMATIONS (Continued)	FROM	TO
RECEIVED		
FEB 22 1991		
Dept. of Environmental Quality Bureau of Land & Water Resources		
IF MORE SPACE IS NEEDED, USE BACK		

If well telescopes please
sketch and show depths.

GROUND LEVEL

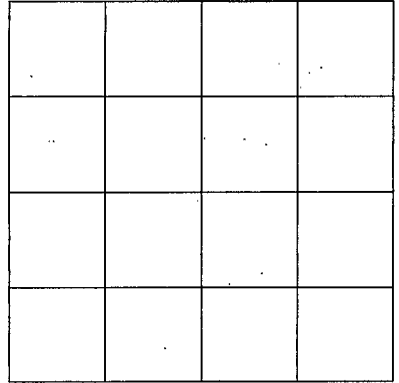

SECTION _____

Please indicate well location X.

ADDITIONAL INFORMATION

If more than one screen,
show location of each on sketch.