

Marshall

U. 2000

10-16-75

MISSISSIPPI BOARD OF WATER COMMISSIONERS  
416 North State Street  
Jackson, Mississippi 39201

WATER WELL DRILLERS LOG

OCT 16

1975

Billy R. SIMPSON

MARSHALL

date well completed

firm name

county well located

LANDOWNER:

Wm D. Ford

Potts Camp, MS  
(mailing address)

WELL LOCATION:

sec. 36 T. 6 N. R. 1 E  
S. 9 W. 5  
9 miles S of Potts Camp  
(distance) (direction) (nearest town)

WELL-PURPOSE: HOME  
(home, irrigation, municipal, industrial)

WELL COMPLETION DATA:

- (1) diameter (inches) 4
- (2) total depth (feet) 540
- (3) static water level (feet) 15 <sup>below</sup> top of ground
- (4) casing POC 133  
(material) (depth)
- (size) If telescope see back.
- (5) screen NONE  
(length) (depth to top)
- (size) (material)
- (6) pump 1/2 10  
(HP) (yield gpm)
- Elec  
(type power)
- (7) electric log No  
(yes or no)
- (organization running log)
- (8) how well bottom plugged

description of formations encountered

from to


SURFACE CLAY	0	10
SAND	10	23
YELLOW CLAY	23	30
Blue CLAY	30	45
ROCK	45	46
Blue CLAY	46	145
ROCK	145	146
Blue CLAY	146	147
ROCK	147	148
Blue CLAY	148	455
LIME STONE SAND-CLAY	455	493
Blue CLAY	493	510
LIME STONE-CORASE	510	540
GREEN SAND		

DRILLERS REMARKS:

JAN 26 1976

If well telescopes please sketch and show depths.

GROUND LEVEL

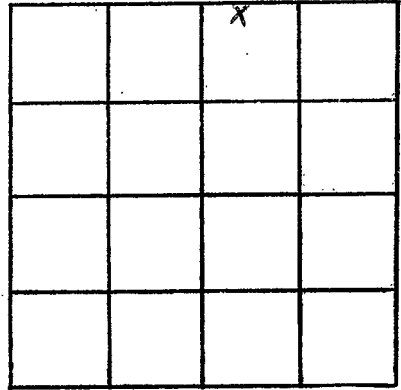

SECTION 36

Please indicate well location X.

ADDITIONAL INFORMATION

If more than one screen, show locations of each on sketch.