

MISSISSIPPI
BOARD OF WATER COMMISSIONERS
416 North State Street
15F Jackson, Mississippi 39201

WATER WELL DRILLERS LOG

Marshall
Y 2001
7/8/76
7/8/76

15F Marshall Well Drilling Marshall
date well completed firm name county well located

Need Section

LANDOWNER: Lannettville

Path Camp Miss
(mailing address)

WELL LOCATION:
sec. 7 T 6 N R 1 E
7 miles South of Path Camp
(distance) (direction) (nearest town)

WELL PURPOSE: Home
(home, irrigation, municipal, industrial)

WELL COMPLETION DATA:

- (1) diameter (inches) 4
- (2) total depth (feet) 650
- (3) static water level (feet) 60 below top of ground.
- (4) casing Plastic 245
(material) (depth)
(size) If telescope see back.
- (5) screen 12 (length) (depth to top)
(size) (material)
- (6) pump 1/2 12
(HP) (yield gpm)
(type power)
- (7) electric log yes or no
(organization running log)
- (8) how well bottom plugged

description of formations encountered	from to	
<u>chert</u>	<u>0</u>	<u>45</u>
<u>clay sand mix</u>	<u>45</u>	<u>200</u>
<u>blue clay</u>	<u>200</u>	<u>600</u>
<u>sand & rock</u>	<u>600</u>	<u>650</u>

RECEIVED


DEC 2 1976

DRILLERS REMARKS:

MISS. BD. OF WATER COMMISSIONERS

If well telescopes please sketch and show depths.

GROUND LEVEL

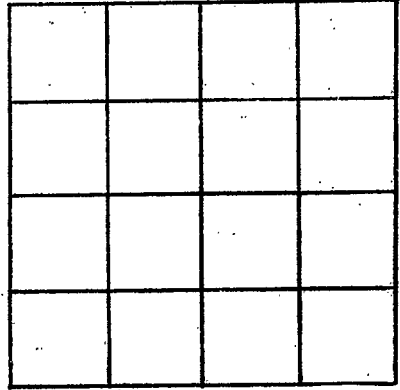

SECTION _____

Please indicate well location X.

ADDITIONAL INFORMATION

If more than one screen, show locations of each on sketch.