

Marshall
 Y 2002
 2/24/77

MISSISSIPPI
 BOARD OF WATER COMMISSIONERS
 416 North State Street
 15F Jackson, Mississippi 39201

WATER WELL DRILLERS LOG

2/24 date well completed
 MedLIN WELL Drilling firm name
 MARSHALL county well located

LANDOWNER: George Wilkins
Potts Camp Ms.
 (mailing address)

Description of formations encountered	from	to
Clay	0	40
Mixed Clay	40	160
Blue Clay	160	660
Sand Run	660	740

WELL LOCATION:
 sec. 5 T. 50 N. R. 2 E
6 miles South of Potts Camp
 (distance) (direction) (nearest town)

WELL PURPOSE:
 (home, irrigation, municipal, industrial)

- WELL COMPLETION DATA:
- (1) diameter (inches) 4
 - (2) total depth (feet) 740'
 - (3) static water level (feet) 75 ^{below} _{above} top of ground.
 - (4) casing 4 240'
 (material) (depth)
 (size) if telescope see back.
 - (5) screen _____
 (length) (depth to top)
 (size) (material)
 - (6) pump 1/2 12
 (HP) (yield gpm)
elec.
 (type power)
 - (7) electric log _____
 (yes or no)
 (organization running log)
 - (8) how well bottom plugged OPEN


DRILLERS REMARKS:

RECEIVED
 AUG 22 1977

MISS. BD. OF WATER COMMISSIONERS

If well telescopes please sketch and show depths.

GROUND LEVEL

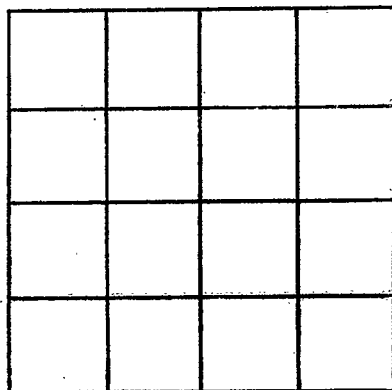

SECTION _____

Please indicate well location X.

ADDITIONAL INFORMATION

If more than one screen, show locations of each on sketch.