

MARSHALL

Y 2003

10/28/77

MISSISSIPPI BOARD OF WATER COMMISSIONERS
416 North State Street
Jackson, Mississippi 39201

WATER WELL DRILLERS LOG

Oct 28 1977 J.W. Wilby Son Marshall
date well completed firm name county well located

LANDOWNER: John Taylor
Potts Camp

(mailing address)

WELL LOCATION:

sec. 5 T. 65 N R. 1 W E
S W
4 1/2 miles S East of Pottocamp
(distance) (direction) (nearest town)

WELL PURPOSE:
(home, irrigation, municipal, industrial)

WELL COMPLETION DATA:

- (1) diameter (inches) 4"
- (2) total depth (feet) 760
- (3) static water level (feet) 129 below top of ground.
- (4) casing Steel 300ft
(material) (depth)
- (size) if telescope see back.
- (5) screen 0 0
(length) (depth to top)
- (size) (material)
- (6) pump 1/2 H.P. Sub 8
(HP) (yield gpm)
- Electric
(type power)
- (7) electric log (yes or no)
- (organization running log)
- (8) how well bottom plugged open

description of formations encountered	from	to
Soil	0	1
Sand + Clay	1	82
Red Coarse Sand	42	95
Sandy Soapstone	85	285
Blue Rock	285	695
Water Rock	695	702
Water Sand Rock	700	760
Ripley sand		


DRILLERS REMARKS:

RECEIVED
FEB - 9 1978

MISS. BD. OF WATER COMMISSIONERS

If well telescopes please sketch and show depths.

GROUND LEVEL

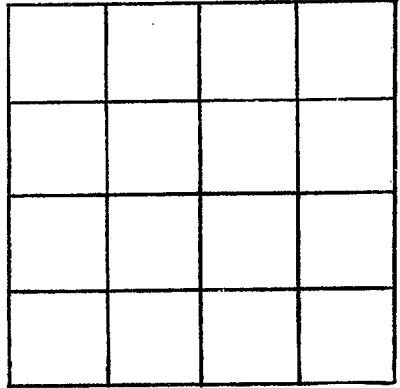

SECTION _____

Please indicate well location X.

ADDITIONAL INFORMATION

If more than one screen, show locations of each on sketch.

11/16/68