

MARSHALL

Y 2004

6-1-78

MISSISSIPPI BOARD OF WATER COMMISSIONERS
416 North State Street
Jackson, Mississippi 39201

WATER WELL DRILLERS LOG

JUNE 1 1978 Billy R Simpson MARSHALL
date well completed firm name county well located


LANDOWNER:	description of formations encountered	from	to
CHESTER HUTCHERS	SURFACE CLAY	0	18
POTTS CAMP, MISS	SAND	18	30
(mailing address)	LIGNITE	30	43
	Blue CLAY	43	91
WELL LOCATION:	ROCK	91	92
sec. <u>25</u> T <u>6</u> N R <u>1</u> E	Blue CLAY	92	195
10 miles S of POTTS CAMP	ROCK	195	196
(distance) (direction) (nearest town)	Blue CLAY	196	460
WELL PURPOSE: <u>HOUSE</u>	WHITE CLAY-SAND. ROCK	460	470
(home, irrigation, municipal, industrial)	COARSE SAND	470	490
	Blue CLAY	490	520
WELL COMPLETION DATA:	LIME STONE + SAND	520	600
(1) diameter (inches) <u>4</u>			
(2) total depth (feet) <u>600</u>			
(3) static water level (feet) <u>23</u> below above of ground.			
(4) casing <u>PVC</u> <u>136</u>			
(material) (depth)			
(size) if telescope see back.			
(5) screen <u>None</u>			
(length) (depth to top)			
(size) (material)			
(6) pump <u>1/2</u> <u>10</u>			
(HP) (yield gpm)			
<u>Flcl</u>			
(type power)			
(7) electric log <u>No</u>			
(yes or no)			
(organization running log)			
(8) how well bottom plugged <u>None</u>			
DRILLERS REMARKS:			

RECEIVED
JUN 19 1978

MISS. BD. OF WATER COMM.

If well telescopes please sketch and show depths.

GROUND LEVEL

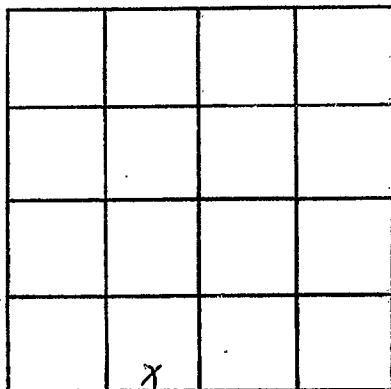

SECTION 25

Please indicate well location X.

ADDITIONAL INFORMATION

If more than one screen,
show locations of each on sketch.