

MARSHALL

Y 2005

8-31-78

MISSISSIPPI BOARD OF WATER COMMISSIONERS 416 North State Street Jackson, Mississippi 39201

WATER WELL DRILLERS LOG

Aug 31 1978 date well completed

J. W. Wilkerson firm name

Marshall county well located

LANDOWNER: James Ray

description of formations encountered	from	to
soil	0	1
Red Clay	1	2.5
Dark yellow sand	2.5	170
Blue Clay + sand	170	190
Blue Rock	190	510
Grey sand + rocks	510	640
Green sand Rock	540	640


Hickory Flat (mailing address)

WELL LOCATION: sec. 12 T. 65 N S R. 10 E W 3 miles West of Cornsall (distance) (direction) (nearest town)

WELL PURPOSE: (home, irrigation, municipal, industrial)

WELL COMPLETION DATA:

- (1) diameter (inches) 4
- (2) total depth (feet) 640
- (3) static water level (feet) 49 below top of ground
- (4) casing Steel 210 (material) (depth)
- (5) screen (size) (length) (depth to top)
- (6) pump 3/4 Sub 1.0 (HP) (yield gpm) Elec (type power)
- (7) electric log (yes or no)
- (8) how well bottom plugged open

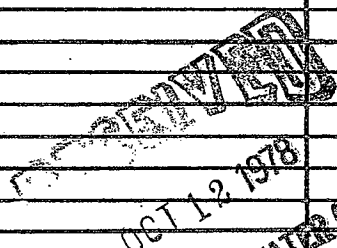

DRILLERS REMARKS:

If well telescopes please sketch and show depths.

GROUND LEVEL

SECTION _____

Please indicate well location X.

ADDITIONAL INFORMATION

If more than one screen,
show locations of each on sketch.