

Marshall

MISSISSIPPI
BOARD OF WATER COMMISSIONERS
416 North State Street
Jackson, Mississippi 39201

WATER WELL DRILLERS LOG

4-15-80
April 15 1980
date well completed

J. W. Wehky Sons Marshall
firm name county well located

LANDOWNER: Cornelia Math Church
Hickory Flat (mailing address)
WELL LOCATION:
sec. 24 T 63 N S R 1 W E W
1/4 miles (distance) of Cornelia (direction) of (nearest town)

Description of formations encountered	from	to
Soil	0	1
sand & clay	1	60
Blue marl soil	60	102
Blue marl	100	1480
Water Rock	1480	1485
sand & rocks	1485	602
Will Ripley sand		

WELL PURPOSE:
(home, irrigation, municipal, industrial)

WELL COMPLETION DATA:
(1) diameter (inches) 4"
(2) total depth (feet) 600
(3) static water level (feet) 33 below above top of ground.
(4) casing steel, 126' (material) (depth)
(size) if telescope see back.
(5) screen (length) (depth to top)
(size) (material)
(6) pump 1/2 inch 6 (HP) (yield gpm)
Elec (type power)
(7) electric log (yes or no)
(organization running log)
(8) how well bottom plugged Open


DRILLERS REMARKS:

DEPT. OF NATURAL RESOURCES
BUREAU OF LAND & WATER RESOURCES

JUL - 3 1980
RECEIVED

If well telescopes please sketch and show depths.

GROUND LEVEL

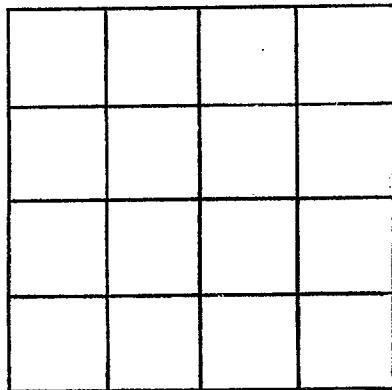

SECTION _____

Please indicate well location X.

ADDITIONAL INFORMATION

If more than one screen, show locations of each on sketch.