

MARSHALL
2011
9-18-80

MISSISSIPPI
 BOARD OF WATER COMMISSIONERS
 416 North State Street
 Jackson, Mississippi 39201

WATER WELL DRILLERS LOG

9-18 1980 JT Maden Marshall
 date well completed firm name county well located

LANDOWNER: Floyd
Berryhill
POTTS CAMP
 (mailing address)

description of formations encountered	from	to
<u>clay</u>	<u>0</u>	<u>4.60</u>
<u>rock & sand</u>	<u>4.60</u>	<u>67.0</u>

WELL LOCATION:
 sec. 21 T 6 N R 1 E
3 miles S of Bethlehem
 (distance) (direction) (nearest town)

WELL PURPOSE:
 (home, irrigation, municipal, industrial)

- WELL COMPLETION DATA:
- (1) diameter (inches) 4
 - (2) total depth (feet) 67.0
 - (3) static water level (feet) 2 2 below top of ground.
 - (4) casing PVC 200
 (material) (depth)
2" If telescope see back.
 (size)
 - (5) screen 100 540
 (length) (depth to top)
2" 100 PVC
 (size) (material)
 - (6) pump 2 10
 (HP) (yield gpm)
E
 (type power)
 - (7) electric log (yes or no) _____
 - (8) how well bottom plugged cap

DRILLERS REMARKS:


DEPT. OF NATURAL RESOURCES
 BUREAU OF LAND & WATER RESOURCES

OCT 28 1980

RECEIVED

If well telescopes please sketch and show depths.

GROUND LEVEL

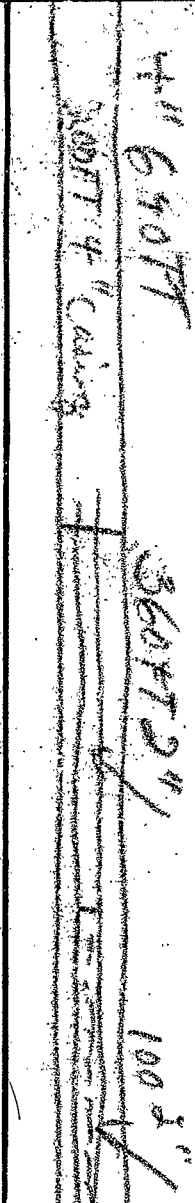

SECTION _____

Please indicate well location X.

ADDITIONAL INFORMATION

If more than one screen, show locations of each on sketch.