

MARSHALL

MISSISSIPPI
BOARD OF WATER COMMISSIONERS
416 North State Street
Jackson, Mississippi 39201

WATER WELL DRILLERS LOG

Y 2012

7/1/85 19
date well completed

J. W. Wehler Marshall
firm name county well located

LANDOWNER: James Font

description of formations encountered from to

Rotts Camp (mailing address)

Soil 0 1
Sand & clay 1 50
Blue sandy clay 50 110
Blue Rock soft 110 180
Blue Rock 180 490
Water Rock 490 496
Rock & Sand 496 600
Replay Sand

WELL LOCATION:
sec. 36 T 75 N R 14 E
S W
2 miles S East of (direction) of (nearest town)

WELL PURPOSE:
(home, irrigation, municipal, industrial)

WELL COMPLETION DATA:

- (1) diameter (inches) 4
- (2) total depth (feet) 600
- (3) static water level (feet) 141 below above top of ground.
- (4) casing Steel 200 (material) (depth)
4 (size) if telescope see back.
- (5) screen (length) (depth to top)
(size) (material)
- (6) pump 1/2 sub 6 (HP) (yield gpm)
Elexa (type power)
- (7) electric log (yes or no)
(organization running log)
- (8) how well bottom plugged open

DEPT. OF NATURAL RESOURCES
BUREAU OF LAND & WATER RESOURCES


JUL - 3 1980

RECEIVED

DRILLERS REMARKS:

If well telescopes please sketch and show depths.

GROUND LEVEL

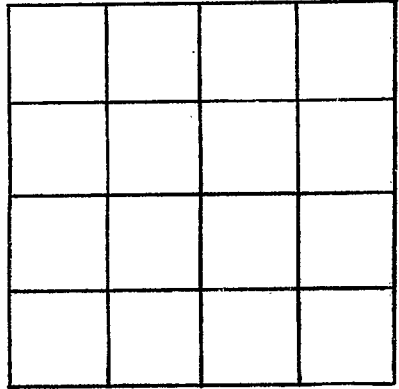

SECTION _____

Please indicate well location X.

ADDITIONAL INFORMATION

If more than one screen, show locations of each on sketch.