

MISSISSIPPI DEPARTMENT OF NATURAL RESOURCES

Bureau of Land and Water Resources

Southport Mall

P.O. Box 10631

Jackson, Mississippi 39209

WATER WELL DRILLERS LOG

MARSHALL
Y 2015

4-18-1986 date well completed
Medlin Water Well firm name
Marshall county well located

LANDOWNER:
Beatrice Flickas
Potts Comp
(mailing address)

WELL LOCATION:
sec. 5 T. 6 N. R. 1 E.
5 miles South of Potts Comp
(distance) (direction) (nearest town)

WELL PURPOSE:
(home, irrigation, municipal, industrial)

- WELL COMPLETION DATA:
- (1) diameter (inches) 4"
 - (2) total depth (feet) 790'
 - (3) static water level (feet) 160 below above top of ground
 - (4) casing PVC (material), 200' (depth)
(size) If telescope see back.
 - (5) screen (length) (depth to top)
(size) (material)
 - (6) pump 1/2 (HP), 11 (yield gpm)
Electric (type power)
 - (7) electric log (yes or no)
(organization running log)
 - (8) how well bottom plugged

description of formations encountered	from	to
Top Soil	0	100
Rock & Clay	100	400
Clay's Blue Clay	400	580
Thick Blue Clay	580	640
Aquifer	640	790


RECEIVED
JUN 27 1986

Department of Natural Resources
Bureau of Land & Water Resources

DRILLERS REMARKS:

If well telescopes please sketch and show depths.

GROUND LEVEL

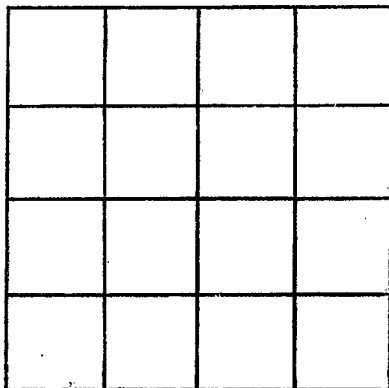

SECTION _____

Please indicate well location X.

ADDITIONAL INFORMATION

If more than one screen,
show locations of each on sketch.