

Marshall  
4 2016

MISSISSIPPI DEPARTMENT OF NATURAL RESOURCES  
Bureau of Land and Water Resources  
Southport Mall  
P.O. Box 10631  
Jackson, Mississippi 39209  
**WATER WELL DRILLERS LOG**


DEC 19 86 CEEPER Drilling Marshall  
date well completed firm name county well located

LANDOWNER: Edwin Churchill  
RT 1 Box 88  
Potts Camp MS -  
(mailing address)  
WELL LOCATION:  
sec. 6 T. 6 N R. 1 E  
5 miles SW of Potts Camp  
(distance) (direction) (nearest town)

description of formations encountered	from	to
Top Clay	0	20
Blue clay	20	100
Brown sand	100	180
Blue clay	180	500
Chalk	500	660
sand	660	720

WELL PURPOSE: Home  
(home, irrigation, municipal, industrial)

- WELL COMPLETION DATA:
- (1) diameter (inches) 4"
  - (2) total depth (feet) 720 ft
  - (3) static water level (feet) 80 below above top of ground
  - (4) casing (material) PVC, (depth) 240', (size) 4" if telescope see back.
  - (5) screen (length) \_\_\_\_\_ (depth to top) \_\_\_\_\_ (size) \_\_\_\_\_ (material) \_\_\_\_\_
  - (6) pump (HP) 1 (yield gpm) 5 (type power) Elec
  - (7) electric log NO (yes or no)  
(organization running log) \_\_\_\_\_
  - (8) how well bottom plugged OPEN

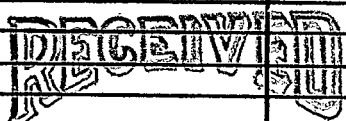


DEC 24 1986

Department of Natural Resources  
Bureau of Land & Water Resources

DRILLERS REMARKS:

If well telescopes please sketch and show depths.

GROUND LEVEL

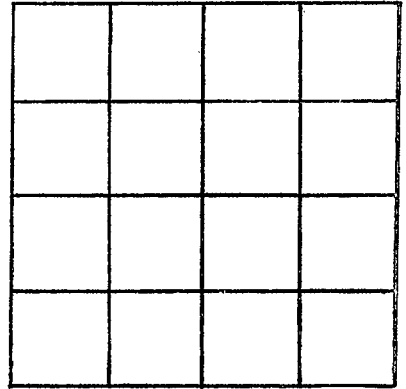

SECTION \_\_\_\_\_

Please indicate well location X.

ADDITIONAL INFORMATION

If more than one screen,  
show locations of each on sketch.