


MISSISSIPPI DEPARTMENT OF ENVIRONMENTAL QUALITY

Office of Land and Water Resources  
 P. O. Box 10631  
 Jackson, MS 39289-0631  
 WATERWELL DRILLERS LOG

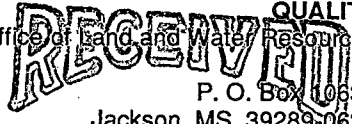

COUNTY WELL LOCATED  
**MARSHALL**  
 WELL NUMBER CODED  
**Y 2018**  
 DATE WELL COMPLETED  
**10-27-99**

PERMIT NUMBER  
 NAME OF DRILLING COMPANY  
**HICKS WELL CO.**  
 SENATORIA, MS 38669

NAME & MAILING ADDRESS OF LANDOWNER  
**GENE SANDERS**  
**2663 Hwy 349S.**  
**BoHs Camp, MS 38659**  
 WELL LOCATION: SEC **5** TOWNSHIP **6** RANGE **1**  
 DISTANCE **1/2** Miles DIRECTION **N** of NEAREST TOWN **Bethlehem**  
 OTHER LANDMARK  
 WELL PURPOSE:  Home,  Irrigation,  Municipal,  Industrial,  Fish Pond, etc.

PUMP DATA  
 PUMP TYPE (Circle One):  Submersible,  Surface,  Flowing Well, Other (Describe)  
 POWER TYPE (Circle One):  Electric,  Tractor,  Diesel,  Gasoline,  Butane, Other (Describe) **H/P 1/2**  
 Pump Capacity (GPM) **12** No. of Stages Setting Depth **90** FT.  
 PUMP TEST  
 Well yielded \_\_\_\_\_ GPM with a drawdown of \_\_\_\_\_ ft. after \_\_\_\_\_ hours of pumping

WELL DATA  
 Well Depth **176** Casing Diameter (In.) **4** Casing Length (Ft.) **166**  
 Type of Casing **PVC** Hole Depth **176** Depth to Static Water Level **65**  
 TYPE OF COMPLETION: (Circle One or More):  Gravel Packed,  Underreamed,  Telescoped,  Natural Development,  Open Hole,  Other (Describe)  
 WELL GROUTED TO A DEPTH OF **3** FEET  
 Type Grout (circle one): Cement,  Bentonite, or Mix

LOG DATA  
 TYPE OF LOG RUN (Circle One):  No Log Run,  Electric,  Gamma Ray,  Density,  Sonic,  Neutron, Other (Describe)  
 Name of Organization Running Log

SCREEN DATA  
 Diameter - Inches **4** Length - Feet **10** Slot Size - Inches **.014**  
 Screen Type **PVC Slotted** Depth to Bottom - Feet **166**

GEOLOGIC DATA (Office Use Only)

Surface Elev.	Geologic Unit	Unit Thickness	Depth to Top
Subs. SWL	Date	Analysis	Aquifer Test


Driller's Remarks  
 Top of Lap Pipe or Reduction in Casing  
 FEET IF TELESCOPED OR MORE THAN ONE SCREEN: USE BACK PAGE

DESCRIPTION OF FORMATIONS ENCOUNTERED	FROM	TO	FORMATIONS (Continued)	FROM	TO
Red + White Clay	0	15			
Black + Gray Clay	15	25			
Gray Clay	25	70			
White Sand	70	176			

IF MORE SPACE IS NEEDED, USE BACK

If well telescopes please  
sketch and show depths.

GROUND LEVEL

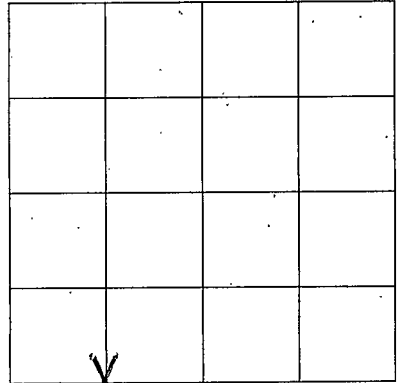

SECTION 5

Please indicate well location X.

ADDITIONAL INFORMATION

If more than one screen,  
show location of each on sketch.