

MISSISSIPPI DEPARTMENT OF ENVIRONMENTAL QUALITY

Office of Land and Water Resources

P. O. Box 10631
Jackson, MS 39289-0631

WATER WELL DRILLERS LOG

COUNTY WELL LOCATED
MASSAHI

WELL NUMBER
Y2019

DATE WELL COMPLETED
6-2-99

PERMIT NUMBER

NAME OF DRILLING FIRM
**N. MS Well Drilling
Brent Longford**

NAME & MAILING ADDRESS OF LANDOWNER
**John McKewan
Bethelam Rd
Potts Camp Miss**

WELL LOCATION: SEC **17** TOWNSHIP **6** RANGE **1**

DISTANCE **2** Miles **S.** of **Bethelam**

OTHER LANDMARK

WELL PURPOSE: Home, Irrigation, Municipal, Industrial, Fish Pond, etc.
Home

PUMP DATA

PUMP TYPE (Circle One):
Submersible Turbine, Jet, Flowing Well,
Other (Describe)

POWER TYPE (Circle One):
Electric Tractor, Diesel, Gasoline, Butane,
Other (Describe) **H/P**

Pump Capacity (GPM) **12** No. of Stages **140** Setting Depth **140** FT.

PUMP TEST

Well yielded **20** GPM with
a drawdown of **10** ft.
after **2** hours of pumping

WELL DATA

Well Depth 155	Casing Diameter (In.) 4	Casing Length (Ft.) 20
Type of Casing PVC	Hole Depth 155	Depth to Static Water Level 60 FEET

TYPE OF COMPLETION: (Circle One or More):
Natural Development, Gravel Packed, Underreamed, Telescoped,
Open Hole, Other (Describe)

LOG DATA

TYPE OF LOG RUN (Circle One):
Electric, Gamma Ray, Density, Sonic, Neutron,
Other (Describe) **No Log Run**

Name of Organization Running Log

WELL GROUTED TO A DEPTH OF **0** FEET
Type Grout (circle one): Cement, Bentonite or Mix

GEOLOGIC DATA (Office Use Only)

Surface Elev.	Geologic Unit	Unit Thickness	Depth to Top
Subs. SWL	Date	Analysis	Aquifer Test

SCREEN DATA

Diameter - Inches 4	Length - Feet 10	Slot Size - Inches 1/13
Screen Type Noted PVC	Depth to Bottom - Feet	

Driller's Remarks

DESCRIPTION OF FORMATIONS ENCOUNTERED	FROM	TO
DIRT	0	10
Light Blue CLAY	10	40
Yellow-Brown SAND	40	80
Blue CLAY	80	110
Dark CLAY	110	130
Light CLAY	130	160
SAND	160	155


FORMATIONS (Continued)

FROM	TO

JAN 12 2000

Dept. of Environmental Quality
Office of Land & Water Resources

IF MORE SPACE IS NEEDED, USE BACK

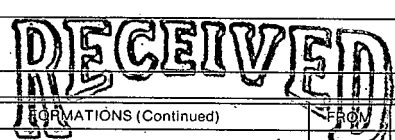

If well telescopes please sketch and show depths.

GROUND LEVEL

			X

SECTION 17

Please indicate well location X.

ADDITIONAL INFORMATION

If more than one screen,
show location of each on sketch.