

NR0E

WATER WELL DRILLERS LOG

Date: 8-N-1960, Driller: Edwing Gas Co County Monroe

8-15-60

685-2-11

(Name)

(1) Owner of Land:	Description & Color of Materials Sand, Clay, Red Clay, Shell, etc.	Thick- ness Feet	Depth Feet
(Name) <u>Allen S. Taylor</u> (Address) <u>Merittown, Miss.</u>			
(2) Location: <u>1/4, 1/4, Sec 17, 18, T14R18,</u> _____ miles _____ of _____ (distance) (direction) (Nearest Town)			
(3) Topography: _____ (Hilly) (Flat) (Level)			
(4) Purpose of Well: <u>Household</u> (Domestic Irrigation Municipal, Industrial, Other)			


Information upon completion of well:

- (1) Diameter 4 inches.
- (2) Total Depth 185 feet.
- (3) Water Level 50 feet below top of ground.
- (4) Cased to 18', Size 4"
- (5) Screen: Size _____, Length _____.
- (6) Were any formations sealed against pollution?
 yes, _____ no.

If YES depth of formation 18'

Why _____

Drillers Remarks: _____

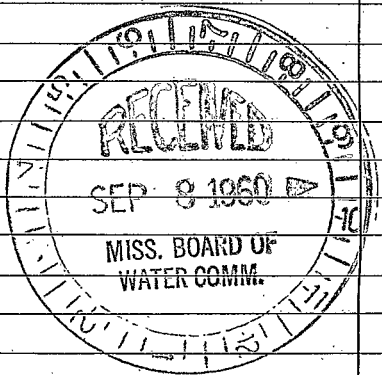

(Use Back Side)

Well No.

