

MONROE

MISSISSIPPI BOARD OF WATER COMMISSIONERS

A 24

11-62

WATER WELL DRILLERS LOG

Carlloss

(P) Loyre - Central Lee

Date: Nov., 1963, Driller: C. Shelton County and Monroe

(Name)

(1) Owner of Land: Town of Nettleton
(Name)

Nettleton, Mississippi
(Address)

Highway 45 South

(2) Location: 1/4, 1/4, Sec. T. R.

 miles of (Nearest Town)
(distance) (direction)

(3) Topography:
(Hilly) (Flat) (Level)

(4) Purpose of Well: Municipal
(Domestic Irrigation
Municipal, Industrial, Other)

Information upon completion of well:

(1) Diameter 12 inches.

(2) Total Depth 272'-8" feet.

(3) Water Level 56'-6" feet below top of ground.

(4) Cased to 201' Size 12"

(5) Screen: Size 6" Length 60'


(6) Were any formations sealed against pollution?
 yes, no.

If YES depth of formation

Why

Drillers Remarks:

Description & Color of Materials Sand, Clay, Red Clay, Shell, etc.	Thick- ness Feet	Depth Feet
Hard Clay	12	12
Yellow Clay	3	15
Sandy Clay	5	20
Hard Selma Chalk w/ thin Layers Hard Rock	57	77
Sandy Shale	12	89
Hard Shale - Strks Sand	23	112
Shale, Sand & Shells	44	156
Hard Shale	4	160
Sand	20	180
Hard Blue Clay	15	195
Fine W.B. Sand	52	247
Sand w/ Strks. Lignite	23	270
Sand w/ Strks. Shale	22	292
Hard Clay	8	300

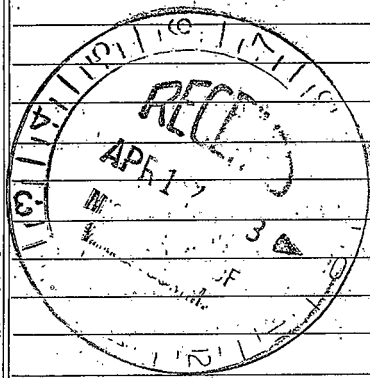

(Use Back Side)

Well No.

