

CODED

MISSISSIPPI  
BOARD OF WATER COMMISSIONERS  
416 North State Street  
Jackson, Mississippi 39201

CODED

WATER WELL DRILLERS LOG

Monroe  
A 26  
10-11-68

10-11 1968 Heardon-Roman Well & Supply, Inc. Monroe  
date well completed firm name Box 42 county well located  
1st no on left

LANDOWNER:  
HW 45 256 B1044 LOCKETT  
WILLIE MARY LOCKETT  
Rt 2 Nettleton, MS  
(mailing address)

description of formations encountered	from	to
<u>Surface mud clay</u>	<u>0</u>	<u>30</u>
<u>Blue clay</u>	<u>30</u>	<u>200</u>
<u>Sand</u>	<u>200</u>	<u>340</u>
<u>BETH</u>	<u>340</u>	

WELL LOCATION:  
23 1/4 sec. T 12 N R 6 E  
3 miles S of Nettleton  
(distance) (direction) (nearest town)

WELL PURPOSE: Home  
(home, irrigation, municipal, industrial)

- WELL COMPLETION DATA:
- (1) diameter (inches) 5
  - (2) total depth (feet) 340
  - (3) static water level (feet) 113 below top of ground.
  - (4) casing steel 33' (material) (depth)  
5" if telescope see back. (size)
  - (5) screen 100 (length) (depth to top)  
(size) (material)
  - (6) pump 1/2 (HP) 5 (yield gpm)  
electric (type power)
  - (7) electric log No (yes or no)  
(organization running log)
  - (8) how well bottom plugged open

CODED


OCT 10 1968

DRILLERS REMARKS:

MISS. BD. OF  
WATER COMM.

If well telescopes please sketch and show depths.

GROUND LEVEL

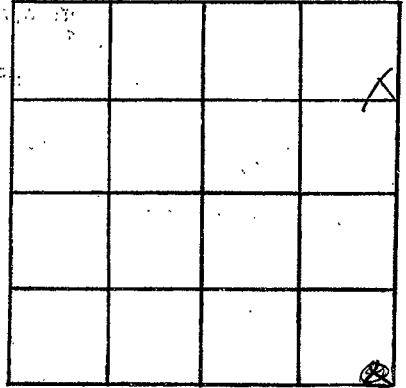

SECTION

23

Please indicate well location X.

ADDITIONAL INFORMATION

If more than one screen, show locations of each on sketch.