

CODED

Monroe  
A 29  
4-1-69

MISSISSIPPI  
BOARD OF WATER COMMISSIONERS  
416 North State Street  
Jackson, Mississippi 39201

CODED

WATER WELL DRILLERS LOG

4-1 date well completed    1965 Herndon & Haman firm name    Monroe county well located

LANDOWNER:	description of formations encountered	from	to
<u>J. T. Burleson</u>			
<u>Rt 2 Nettleton</u> (mailing address)	<u>clay</u>	<u>0</u>	<u>18</u>
	<u>Blue clay</u>	<u>18</u>	<u>180</u>
	<u>sand</u>	<u>180</u>	<u>300</u>
	<u>Bottom</u>	<u>300</u>	
WELL LOCATION:			
sec. <u>22</u> T <u>12</u> N R <u>6</u> E			
<u>4</u> miles <u>S</u> of <u>Nettleton</u>			
(distance) (direction) (nearest town)			
WELL PURPOSE:			
<u>Home</u> (home, irrigation, municipal, industrial)			
WELL COMPLETION DATA:			
(1) diameter (inches) <u>5</u>			
(2) total depth (feet) <u>300</u>			
(3) static water level (feet) <u>115</u> below top of ground.			
(4) casing <u>Steel, 20" 4"</u> (material) (depth)			
<u>5</u> If telescope see back. (size)			
(5) screen <u>NO</u> (length) (depth to top)			
(size) (material)			
(6) pump <u>1/2</u> <u>5</u> (HP) (yield gpm)			
<u>electric</u> (type power)			
(7) electric log <u>NO</u> (yes or no)			
(organization running log)			
(8) how well bottom plugged <u>open</u>			

CODED


APR 30 1969

DRILLERS REMARKS:

MISS. DD. OH  
WATER COMMISSIONERS

If well telescopes please sketch and show depths.

GROUND LEVEL

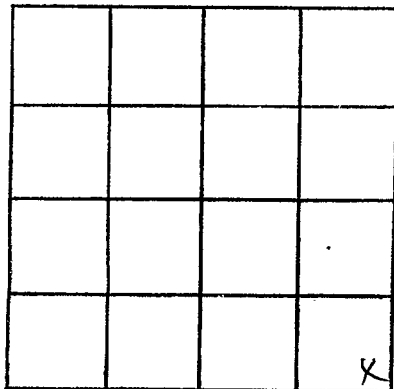

SECTION 22

Please indicate well location X.

ADDITIONAL INFORMATION

Lined area for additional information.

If more than one screen, show locations of each on sketch.