

MONROE
A 30
7-21-69

MISSISSIPPI
BOARD OF WATER COMMISSIONERS
416 North State Street
Jackson, Mississippi 39201

WATER WELL DRILLERS LOG

Monroe

7-21-69 19 Herndon-Homan, Inc Monroe
date well completed firm name county well located

LANDOWNER: L. O. Caldwell
Route 1
Shannon, Miss
(mailing address)

description of formations encountered	from	to
Sand and clay	0	26
Blue Clay	20	250
Sand	280	400
Bottom	400	

WELL LOCATION:
sec 37 T 11 N R 6 E
S W
1 miles S of Shannon
(distance) (direction) (nearest town)

WELL PURPOSE: Home
(home, irrigation, municipal, industrial)


- WELL COMPLETION DATA:
- (1) diameter (inches) 5"
 - (2) total depth (feet) 400
 - (3) static water level (feet) 70 below top of ground.
 - (4) casing Steel 31'3" (material) (depth)
5" (size) If telescope see back.
 - (5) screen 70 (length) (depth to top)
(size) (material)
 - (6) pump 1/2 (HP) 5 (yield gpm)
Elec. (type power)
 - (7) electric log no (yes or no)
 - (8) how well bottom plugged open

DRILLERS REMARKS:

AUG 8 1969
MISS. BD. OF WATER COMMISSIONERS

If well telescopes please sketch and show depths.

GROUND LEVEL

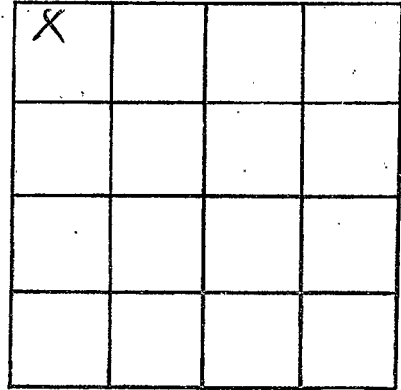

SECTION 31

Please indicate well location X.

ADDITIONAL INFORMATION

If more than one screen,
show locations of each on sketch.