

Monroe
A 31
8-69

48³ MISSISSIPPI
BOARD OF WATER COMMISSIONERS
416 North State Street
Jackson, Mississippi 39201

CODED

WATER WELL DRILLERS LOG

8-13 1969 Herndon-Homan Monroe
date well completed firm name county well located

LANDOWNER Lawrence Johnson
Aberdeen, Miss
(mailing address)

description of formations encountered

	from	to
Surface sand & clay	0	28
Blue clay	28	260
Sand	260	400
Bottom	400	

WELL LOCATION:
sec. 5 T. 11 S. R. 6 E.
2 miles SW of Malden
(distance) (direction) (nearest town)

WELL PURPOSE: Home
(home, irrigation, municipal, industrial)


- WELL COMPLETION DATA:
- (1) diameter (inches) 5"
 - (2) total depth (feet) 400'
 - (3) static water level (feet) 90 below top of ground.
 - (4) casing Steel, 35' (material) (depth)
5" if telescope see back. (size)
 - (5) screen no, (length) (depth to top)
(size) (material)
 - (6) pump Hand (HP) (yield gpm)
(type power)
 - (7) electric log no (yes or no)
(organization running log)
 - (8) how well bottom plugged open

DRILLERS REMARKS:

MISS. Bd. of WATER COMMISSIONERS

If well telescopes please sketch and show depths.

GROUND LEVEL

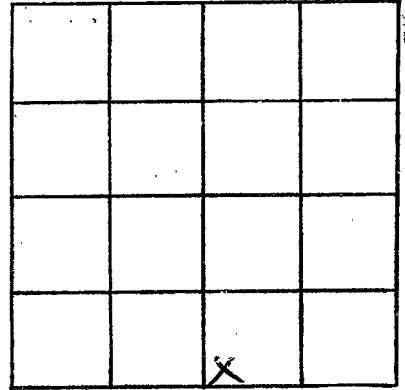

SECTION 5

Please indicate well location X.

ADDITIONAL INFORMATION

If more than one screen,
show locations of each on sketch.