

Monroe
A 37
5-20-70

MISSISSIPPI
BOARD OF WATER COMMISSIONERS
416 North State Street
Jackson, Mississippi 39201

CODED

WATER WELL DRILLERS LOG

5-20 1970 Gerndon-Homan Well # Monroe
date well completed firm name county well located

LANDOWNER: Sherman Schlicht description of formations encountered from to
Route 2 surface sand & clay 0 18
Nettleton, Miss. Blue clay 18 200
(mailing address) Sand 200 400
Bottom 400

WELL LOCATION:
sec. 9 T. 12 R. 6
3 miles SW of Nettleton
(distance) (direction) (nearest town)

WELL PURPOSE: None
(home, irrigation, municipal, industrial)

- WELL COMPLETION DATA:
- (1) diameter (inches) 5"
 - (2) total depth (feet) 400'
 - (3) static water level (feet) 145 below top of ground.
 - (4) casing Steel, 21'
(material) (depth)
5" if telescope see back.
(size)
 - (5) screen 70
(length) (depth to top)
(size) (material)
 - (6) pump 1/2 5
(HP) (yield gpm)
Electric
(type power)
 - (7) electric log no
(yes or no)
 - (organization running log)
 - (8) how well bottom plugged open

CODED


JUL 20 1970

DRILLERS REMARKS:

MISS. Bd. of
WATER Comm.

If well telescopes please sketch and show depths.

GROUND LEVEL

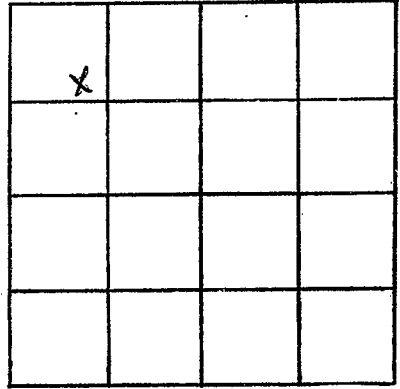

SECTION 9

Please indicate well location X.

ADDITIONAL INFORMATION

If more than one screen,
show locations of each on sketch.