

Monroe
A 38
5-28-70

MISSISSIPPI
BOARD OF WATER COMMISSIONERS
416 North State Street
Jackson, Mississippi 39201

CODED

WATER WELL DRILLERS LOG
Herndon-Homan Well & Supply, Inc.
P. O. Box 42
SHANNON, MISSISSIPPI 38868 county well located

528 1970
date well completed

Monroe

LANDOWNER: Lee Fields
Route 1
Shannon, Miss
(mailing address)

| description of formations encountered | from | to |
|---------------------------------------|------------|------------|
| <u>surface sand & clay</u> | <u>0</u> | <u>18</u> |
| <u>Blue clay</u> | <u>18</u> | <u>20</u> |
| <u>Sand</u> | <u>20</u> | <u>340</u> |
| <u>Bottom</u> | <u>340</u> | |

WELL LOCATION:
sec 32 T 11 N R 6 E
3 1/2 miles W of Jettleton
(distance) (direction) (nearest town)

WELL PURPOSE: Home
(home, irrigation, municipal, industrial)

- WELL COMPLETION DATA:
- (1) diameter (inches) 5"
 - (2) total depth (feet) 340'
 - (3) static water level (feet) 60 below top of ground.
 - (4) casing Steel 21'
(material) (depth)
5" if telescope see back.
(size)
 - (5) screen no
(length) (depth to top)
(size) (material)
 - (6) pump 1/3 5
(HP) (yield gpm)
Electric
(type power)
 - (7) electric log no
(yes or no)
 - (organization running log)
 - (8) how well bottom plugged Open


CODED

DRILLERS REMARKS:

JUN 15 1970

If well telescopes please sketch and show depths.

GROUND LEVEL

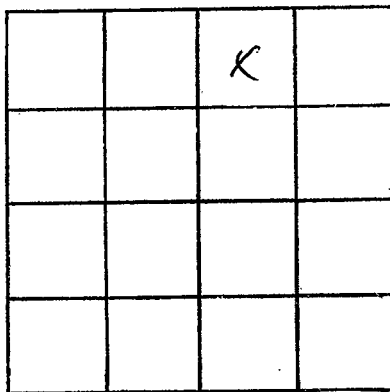

SECTION 32

Please indicate well location X.

ADDITIONAL INFORMATION

If more than one screen,
show locations of each on sketch.