

MONROE  
A 39  
7-13-70

MISSISSIPPI  
BOARD OF WATER COMMISSIONERS  
416 North State Street  
Jackson, Mississippi 39201

CODED

WATER WELL DRILLERS LOG

7-13 1970 Herndon Home Well # Monroe  
date well completed firm name county well located

Supply

LANDOWNER: Thomas Mc Gowan  
Route 1  
Shannon, Miss.  
(mailing address)

description of formations encountered	depth	
	from	to
Surface sand & clay	0	18
Blue clay	18	200
Sand	200	360
Bottom	360	

WELL LOCATION:  
sec. 31 T. 11 N. R. 6 E  
1 1/2 miles S of Shannon  
(distance) (direction) (nearest town)

WELL PURPOSE: home  
(home, irrigation, municipal, industrial)

- WELL COMPLETION DATA:
- (1) diameter (inches) 5"
  - (2) total depth (feet) 360'
  - (3) static water level (feet) 25 below top of ground.
  - (4) casing Steel, 28" (material), (depth)  
5" (size) if telescope see back.
  - (5) screen no (length), (depth to top)  
(size) (material)
  - (6) pump 1/2 (HP) Electric (yield gpm)  
Electric (type power)
  - (7) electric log no (yes or no)  
(organization running log)
  - (8) how well bottom plugged open

CODED


AUG 26 1970

DRILLERS REMARKS:

MISS. BD. OF  
WATER COMMISSIONERS

If well telescopes please sketch and show depths.

GROUND LEVEL

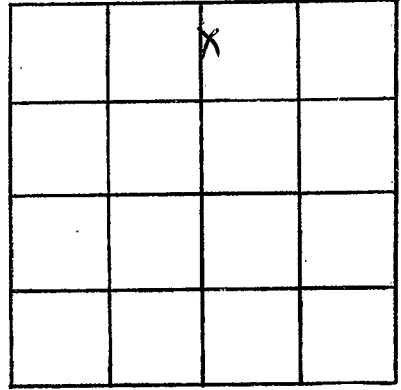

SECTION 31

Please indicate well location X.

ADDITIONAL INFORMATION

If more than one screen,  
show locations of each on sketch.