

MONROE  
A 40  
10-5-70

MISSISSIPPI  
BOARD OF WATER COMMISSIONERS  
416 North State Street  
Jackson, Mississippi 39201

**CODED**

WATER WELL DRILLERS LOG

10-5 1970 Herndon-Homan, Lva Monroe  
date well completed firm name county well located

LANDOWNER: Herndon R. Seymour  
Nettleton, Miss.  
(mailing address)

description of formations encountered	from	to
Surface sand & clay	0	18
Red clay	18	280
Sand	180	320
Both	320	

WELL LOCATION:  
sec. 3 T. 12 N R. 6 E  
3/4 miles SW of Nettleton  
(distance) (direction) (nearest town)

WELL PURPOSE: none  
(home, irrigation, municipal, industrial)

- WELL COMPLETION DATA:
- (1) diameter (inches) 5"
  - (2) total depth (feet) 320'
  - (3) static water level (feet) 95' below above top of ground.
  - (4) casing Steel, 21'6"  
(material) (depth)
  - 5" if telescope see back.  
(size)
  - (5) screen no  
(length) (depth to top)
  - (size) (material)
  - (6) pump 1/2 5  
(HP) (yield gpm)
  - Electric  
(type power)
  - (7) electric log no  
(yes or no)
  - (organization running log)
  - (8) how well bottom plugged open

**CODED**


NOV 13 1970

DRILLERS REMARKS:

RECEIVED BY OF  
MISSISSIPPI BOARD OF WATER COMMISSIONERS

If well telescopes please sketch and show depths.

GROUND LEVEL

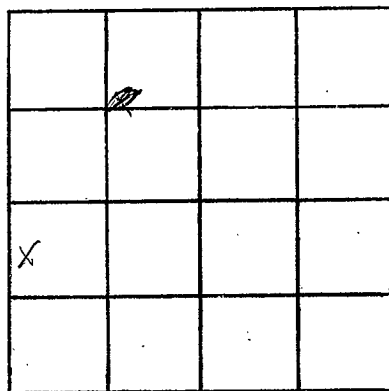

SECTION 3

Please indicate well location X.

ADDITIONAL INFORMATION

If more than one screen, show locations of each on sketch.