

MONROE
A 41
5-4-71

MISSISSIPPI
BOARD OF WATER COMMISSIONERS
416 North State Street
Jackson, Mississippi 39201

CODED

WATER WELL DRILLERS LOG

5-4 1971 Herndon-Herman Well & Monroe
date well completed firm name county well located
Take L Before Bt 1st No. on L. Supply

LANDOWNER: Sammy Lagone

description of formations encountered

from to

Route 2

Surface sand & clay 0 15

15 200

Nettleton, Miss
(mailing address)

Blue clay 15 200

200 340

Bottom 340

WELL LOCATION:

sec 10 T 12 N R 6 E
S W
(1/2 miles SW of Nettleton)
(distance) (direction) (nearest town)

WELL PURPOSE: Home
(home, irrigation, municipal, industrial)

WELL COMPLETION DATA:

- (1) diameter (inches) 5"
- (2) total depth (feet) 340
- (3) static water level (feet) 75 below top of ground.
- (4) casing (material) Steel (depth) 17
5" (size) if telescope see back.
- (5) screen no (length) (depth to top)
(size) (material)
- (6) pump 1/2 (HP) 5 (yield gpm)
electric (type power)
- (7) electric log no (yes or no)

(organization running log)

(8) how well bottom plugged Open

DRILLERS REMARKS:


CODED

MAY 12 1971

MISS. BD. OF
WATER COMMISSIONERS

If well telescopes please sketch and show depths.

GROUND LEVEL

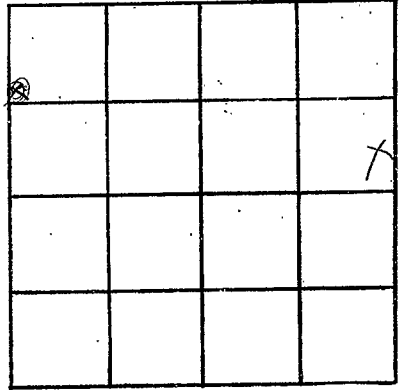

SECTION ~~#~~ 10

Please indicate well location X.

ADDITIONAL INFORMATION

If more than one screen, show locations of each on sketch.