

MONROE
A 44
6-25-71

MISSISSIPPI
BOARD OF WATER COMMISSIONERS
416 North State Street
Jackson, Mississippi 39201

CODED

WATER WELL DRILLERS LOG

Hornon-Hornan Well & Supply, Inc.

P. O. Box 42

Monroe

6-25 1971
date well completed 1971
TULSA OK DIST COG 501M THERT END OF RD
name MISSISSIPPI 1896 county well located

LANDOWNER: James J. Payne
Route 2
Natchitoches, Miss.
(mailing address)
WELL LOCATION:
sec. 13 T-12 R-6 E
2 miles SE of Natchitoches
(distance) (direction) (nearest town)

description of formations encountered	from	to
Surface sand & clay	0	33
Blue clay	33	150
Sand	150	294
Bottom	294	

WELL PURPOSE: Home
(home, irrigation, municipal, industrial)

- WELL COMPLETION DATA:
- (1) diameter (inches) 5"
 - (2) total depth (feet) 294'
 - (3) static water level (feet) 102 below top of ground
 - (4) casing Steel 36" (material) (depth)
 - 5" If telescope see back. (size)
 - (5) screen no (length) (depth to top)
 - (size) (material)
 - (6) pump no (HP) (yield gpm)
 - (type power)
 - (7) electric log no (yes or no)
 - (organization running log)
 - (8) how well bottom plugged open

CODED


JUL 12 1971

MISS. BD. OF
WATER COMM.

DRILLERS REMARKS:

If well telescopes please sketch and show depths.

GROUND LEVEL

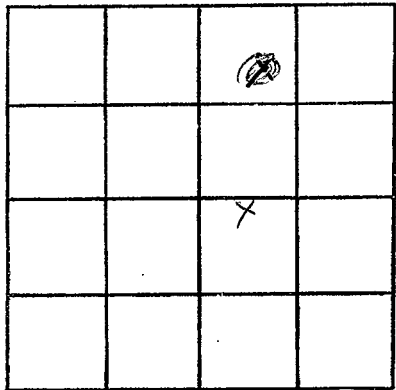

SECTION 13

Please indicate well location X.

ADDITIONAL INFORMATION

If more than one screen, show locations of each on sketch.