

MONROE
A-45
8-16-71

MISSISSIPPI
 BOARD OF WATER COMMISSIONERS
 416 North State Street
 Jackson, Mississippi 39201

CODED

WATER WELL DRILLERS LOG

Warren-Homan Well & Supply, Inc.

8-16 19 71 date well completed
 SHANNON, MISSISSIPPI firm name
 Monroe county well located

LANDOWNER:	description of formations encountered	from	to
James W. Coppin Route 2	Surface sand & clay	0	25
Nettleton, Miss 38858 (mailing address)	Blue clay Sand Bottom	25 250 400	200 400
WELL LOCATION: sec. 9 T. 12 R. 6 3 miles SW of Nettleton (distance) (direction) (nearest town)			
WELL PURPOSE: home (home, irrigation, municipal, industrial)			
WELL COMPLETION DATA:			
(1) diameter (inches) 5"			
(2) total depth (feet) 400'			
(3) static water level (feet) 150 below above top of ground.			
(4) casing Steel 32' (material) (depth)			
5" if telescope see back. (size)			
(5) screen NO (length) (depth to top)			
(size) (material)			
(6) pump 1/2 5 (HP) (yield gpm)			
electric (type power)			
(7) electric log NO (yes or no)			
(organization running log)			
(8) how well bottom plugged open			

CODED


SEP 7 1971

MISS. BD. OF WATER COMM.

DRILLERS REMARKS:

If well telescopes please sketch and show depths.

GROUND LEVEL

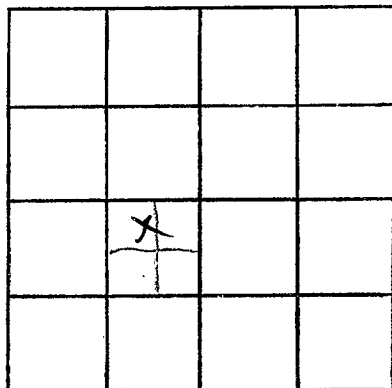

SECTION 9

Please indicate well location X.

ADDITIONAL INFORMATION

If more than one screen, show locations of each on sketch.