

MONROE

MISSISSIPPI BOARD OF WATER COMMISSIONERS

A 46

Coded.

10/

**CODED**

6-30-62

WATER WELL DRILLERS LOG

HERNDON WELL & SUPPLY CO.

Date: Mar 30, 1962, Driller: P. O. BOX 42 County Monroe

SHANNON, MISSISSIPPI  
(Name)

	Description & Color of Materials Sand, Clay, Red Clay, Shell, etc.	Thick- ness Feet	Depth Feet
(1) Owner of Land: <u>Dig Deed MG, Co</u> (Name) <u>Amory, Miss</u> (Address)	<u>Surface sand</u>		<u>0</u>
(2) Location: <u>SW 5 1/4, SE 1/4, Sec 36 T 12 S R 6 E</u> <u>6</u> miles <u>South</u> of <u>Natchez</u> (distance) (direction) (Nearest Town)	<u>&amp; clay</u> <u>Blue rock</u>		<u>25</u>
(3) Topography: <u>Flat</u> (Hilly) (Flat) (Level)	<u>Sand</u>		<u>180</u>
(4) Purpose of Well: <u>Industrial</u> (Domestic Irrigation Municipal, Industrial, Other)	<u>Bottom</u>		<u>300</u>



Information upon completion of well:

- (1) Diameter 6" inches.
- (2) Total Depth 300' feet.
- (3) Water Level 115 feet below top of ground.
- (4) Cased to 27', Size 6".
- (5) Screen: Size —, Length —.
- (6) Were any formations sealed against pollution?  
 yes,  no.

If YES depth of formation 25'

Why, Surface & Sand

Drillers Remarks:  
330 CI 10'

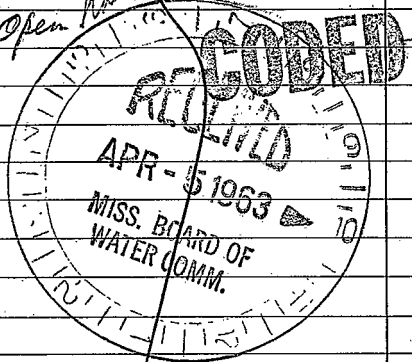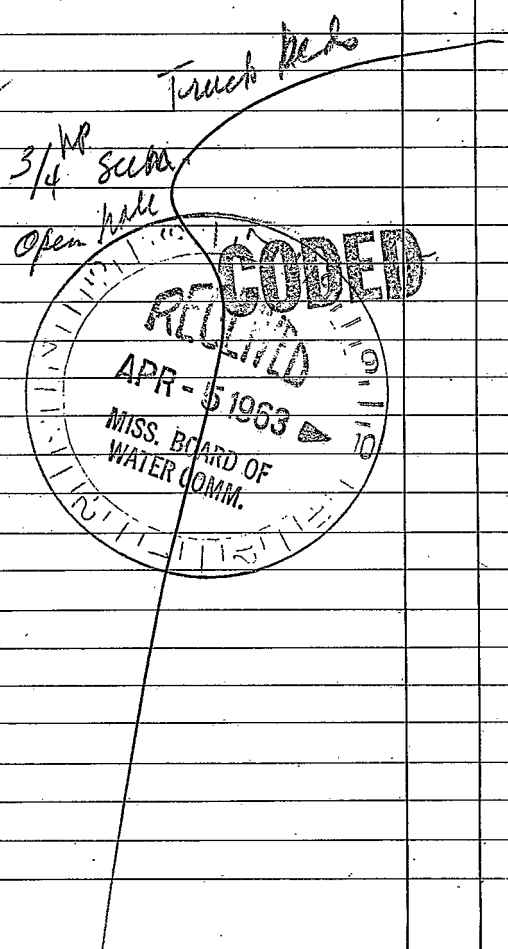

(Use Back Side)

Well No.

