

**MONROE**  
**A49**  
**2-25-72**

MISSISSIPPI  
 BOARD OF WATER COMMISSIONERS  
 416 North State Street  
 Jackson, Mississippi 39201

**CODED**

**WATER WELL DRILLERS LOG**

Herndon-Homan Well & Supply, Inc.

*Monroe*

*2/25* 19 *72*  
 date well completed

P. O. Box 49

**SHANNON, MISSISSIPPI 38608** county well located

LANDOWNER:	description of formations encountered	from	to
<i>George Gardner</i>			
<i>PO Box Okolona, Miss</i> (mailing address)	<i>blue clay</i>	<i>18</i>	<i>260</i>
	<i>Sand</i>	<i>260</i>	<i>400</i>
	<i>Bottom</i>	<i>400</i>	
<b>WELL LOCATION:</b>			
sec. <i>17</i> T. <i>12</i> N R. <i>6</i> E S <i>3</i> miles SW of <i>Nettleton</i> (distance) (direction) (nearest town)			
<b>WELL PURPOSE:</b> (home, irrigation, municipal, industrial) <i>Home</i>			
<b>WELL COMPLETION DATA:</b>			
(1) diameter (inches) <i>5</i>			
(2) total depth (feet) <i>400</i>			
(3) static water level (feet) <i>167</i> below top of ground.			
(4) casing <i>steel</i> , <i>20'8"</i> (material) (depth)			
<i>5</i> if telescope see back. (size)			
(5) screen <i>NO</i> (length) (depth to top)			
(size) (material)			
(6) pump <i>1/2</i> <i>5</i> (HP) (yield gpm)			
<i>electric</i> (type power)			
(7) electric log <i>NO</i> (yes or no)			
(organization running log)			
(8) how well bottom plugged <i>open</i>			


**CODED**

DRILLERS REMARKS:

MAR 10 1972

If well telescopes please sketch and show depths.

GROUND LEVEL

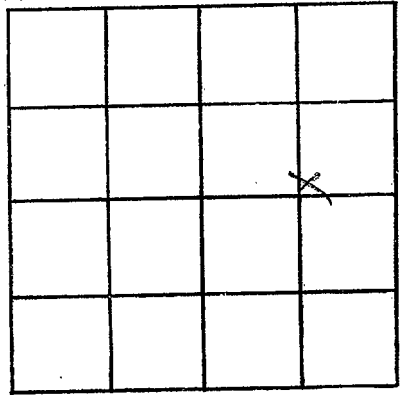

SECTION 17

Please indicate well location X.

ADDITIONAL INFORMATION

If more than one screen, show locations of each on sketch.