

MONROE

MISSISSIPPI BOARD OF WATER COMMISSIONERS

A51

6-8-61

WATER WELL DRILLERS LOG

CODED 304

Date: June 8, 1961, Driller: HERNDON WELL & SUPPLY CO. P. O. BOX 42 County: Monroe

1st hood

SHANNON, MISSISSIPPI

(1) Owner of Land: B. C. Worthy
(Name)
Rt 2 Nettles Miss
(Address) 1

(2) Location: SW SE, NW 1/4, Sec 24 T 12 S R 6 E
4 miles SE of Nettles
(distance) (direction) (Nearest Town)

(3) Topography: Flat
(Hilly) (Flat) (Level)

(4) Purpose of Well: Domestic
(Domestic Irrigation
Municipal, Industrial, Other)

Description & Color of Materials Sand, Clay, Red Clay, Shell, etc.	Thick- ness Feet	Depth Feet
<u>Surface sand & clay</u>		<u>0</u>
<u>Blue rock</u>		<u>20</u>
<u>sand</u>		<u>140</u>
<u>Bottom</u>		<u>260</u>

Information upon completion of well:

(1) Diameter 4 inches.

(2) Total Depth 260 feet.

(3) Water Level 110 feet below top of ground.

(4) Cased to 24', Size 4"

(5) Screen: Size _____, Length _____


(6) Were any formations sealed against pollution?
 yes, _____ no.

If YES depth of formation 20'

Why Surface & Sand

Drillers Remarks:

CODED

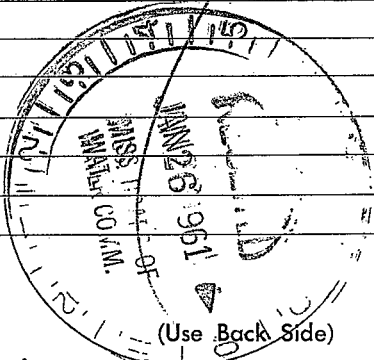

(Use Back Side)

Well No.

