

MONROE

MISSISSIPPI BOARD OF WATER COMMISSIONERS

A52

4-20-62

WATER WELL DRILLERS LOG

CODED

Date: April 20, 1962, Driller: HERNDON WELL & SUPPLY CO. County: Monroe
P.O. BOX #2
SHANNON, MISSISSIPPI

	Description & Color of Materials Sand, Clay, Red Clay, Shell, etc.	Thick- ness Feet	Depth Feet
(1) Owner of Land: <u>Joseph Guzzard</u> <i>HOUSE TORN DOWN</i> (Name) <u>Nettleton, Miss</u> (Address)	<u>Surface soil</u> <u>& clay</u>		<u>0</u>
(2) Location: <u>SE 1/4, SE 1/4, Sec 20 T. 12 S. R. 6 E</u> <u>4</u> miles <u>S W</u> , of <u>Nettleton</u> (distance) (direction) (Nearest Town)	<u>Bottom rock</u> <u>& sand</u>	<u>20</u> <u>140</u>	
(3) Topography: <u>Hilly</u> (Hilly) (Flat) (Level)	<u>&</u>		
(4) Purpose of Well: <u>Domestic</u> (Domestic Irrigation Municipal, Industrial, Other)	<u>Bottom</u>	<u>260</u>	

Information upon completion of well:


- (1) Diameter 4 inches.
- (2) Total Depth 260 feet.
- (3) Water Level 90 feet below top of ground.
- (4) Cased to 21'5", Size 4
- (5) Screen: Size —, Length —
- (6) Were any formations sealed against pollution?
✓ yes, — no.

If YES depth of formation 20 ft.

Why gravel & sand

Drillers Remarks:

CODED

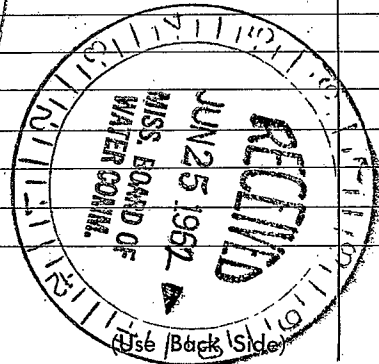

Well No.

1000

1000

