

MONROE

A 53

4-11-61

WATER WELL DRILLERS LOG

CODED

A 301

Date: April 11, 1961, Driller: HERNDON WELL & SUPPLY CO. County Monroe

P.O. BOX 42
SHANNON, MISSISSIPPI

(1) Owner of Land: Morris Seymour
(Name)
Nettles, Miss.
(Address)

(2) Location: SE 1/4, NW 1/4, Sec 3 T125 R6E
(distance) 2 miles S.W., of Nettles
(direction) (Nearest Town)

(3) Topography: _____
(Hilly) (Flat) (Level)

(4) Purpose of Well: Home use
(Domestic Irrigation
Municipal, Industrial, Other)

Description & Color of Materials Sand, Clay, Red Clay, Shell, etc.	Thick- ness Feet	Depth Feet
<u>Surface sand & clay</u>		<u>0</u>
<u>to Blue rock</u>		<u>20</u>
<u>to sand</u>		<u>160</u>
<u>to Bottom</u>		<u>280</u>

Information upon completion of well:

(1) Diameter 4 inches.

(2) Total Depth 280 feet.

(3) Water Level 60' feet below top of ground.

(4) Cased to 23' 2", Size 4".

(5) Screen: Size _____, Length _____.


(6) Were any formations sealed against pollution?
 yes, _____ no.

If YES depth of formation 20'

Why Surface & sand

Drillers Remarks: _____

CODED

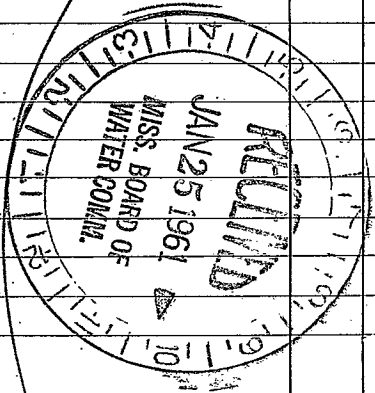

(Use Back Side)

Well No.

