

Monroe  
A56  
7-68

MISSISSIPPI  
BOARD OF WATER COMMISSIONERS  
416 North State Street  
Jackson, Mississippi 39201

CODED

WATER WELL DRILLERS LOG

Herndon-Homan Well & Supply Monroe  
P.O. Box 42  
SHANNON, MISSISSIPPI county well located

7-25 1968  
date well completed

LANDOWNER:  
B.G. Collins  
Natchez Miss  
(mailing address)


description of formations encountered	from	to
Surface Sand	0	20
Blue Clay	20	90
Sand	90	180
Bed	180	

WELL LOCATION:  
36 35 sec. T. 11 N. R. 6 E. S. 5  
1/4 miles W of Natchez  
(distance) (direction) (nearest town)

WELL PURPOSE: Home  
(home, irrigation, municipal, industrial)

- WELL COMPLETION DATA:
- (1) diameter (inches) 5"
  - (2) total depth (feet) 180'
  - (3) static water level (feet) 40' below top of ground.
  - (4) casing steel, 28' 4" (material) (depth)  
5" (size) If telescope see back.
  - (5) screen 20' (length) (depth to top)  
(size) (material)
  - (6) pump HP (HP) (yield gpm)  
(type power)
  - (7) electric log NO (yes or no)  
(organization running log)
  - (8) how well bottom plugged open


CODED

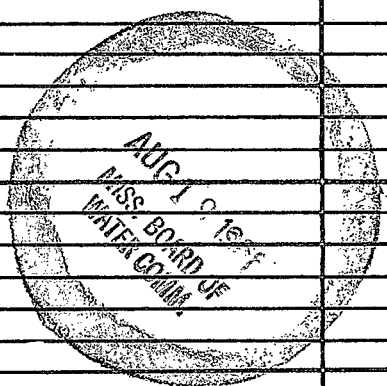

DRILLERS REMARKS:

If well telescopes please sketch and show depths.

GROUND LEVEL

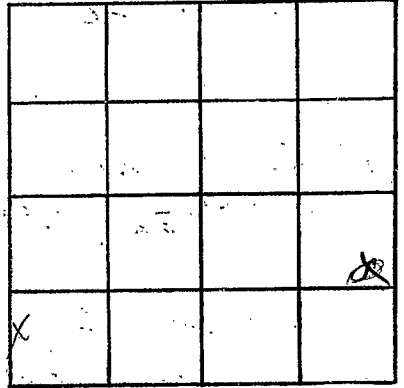

SECTION 3536

Please indicate well location X.

ADDITIONAL INFORMATION

If more than one screen, show locations of each on sketch.