

Monroe
A 57
7-68

MISSISSIPPI
BOARD OF WATER COMMISSIONERS
416 North State Street
Jackson, Mississippi 39201

CODED

WATER WELL DRILLERS LOG

date well completed 7/24 1968 Herndon-Homan Well & Supply, Inc. Monroe
 firm name Box 42 county well located
SHANNON, MISSISSIPPI 38851

LANDOWNER:
B. G. Coccias
Nettleton Miss
(mailing address)

description of formations encountered	from	to
<u>Surface sand</u>		
<u>clay</u>	<u>0</u>	<u>20</u>
<u>blue clay</u>	<u>20</u>	<u>90</u>
<u>sand</u>	<u>90</u>	<u>180</u>
<u>bedrock</u>	<u>180</u>	


WELL LOCATION:
36 38 sec T 11 N R 6 E
S W
7 1/2 miles W of Nettleton
(distance) (direction) (nearest town)

WELL PURPOSE: Home
(home, irrigation, municipal, industrial)

WELL COMPLETION DATA:

- (1) diameter (inches) 5"
- (2) total depth (feet) 180
- (3) static water level (feet) 46 below top of ground.
- (4) casing steel, 9 1/4" (material) (depth)
5" (size) if telescope see back.
- (5) screen no, (length) (depth to top)
(size) (material)
- (6) pump HP (HP) (yield gpm)
(type power)
- (7) electric log no (yes or no)
(organization running log)
- (8) how well bottom plugged open

CODED

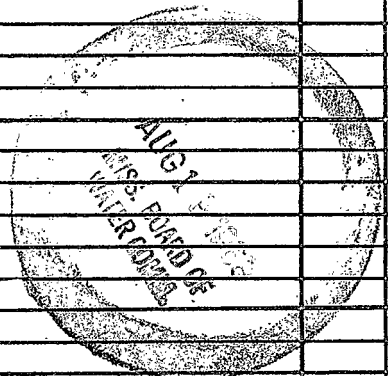

DRILLERS REMARKS:

If well telescopes please sketch and show depths.

GROUND LEVEL

			X
X			

SECTION 2536

Please indicate well location X.

ADDITIONAL INFORMATION

If more than one screen, show locations of each on sketch.