

MONROE
A 58

CODED

8-16-61

WATER WELL DRILLERS LOG

A 300

HERNDON WELL & SUPPLY CO.

Date: Aug 16, 1961, Driller: P. O. BOX 42 County Madison

SHANNON, MISSISSIPPI

Turn Rt. 1st W No

(1) Owner of Land:	Description & Color of Materials Sand, Clay, Red Clay, Shell, etc.	Thick- ness Feet	Depth Feet
(Name) <u>Mrs. B. G. Coppins</u> (Address) <u>Natchez, Miss.</u>	<u>Surface sand & clay</u>		<u>0</u>
(2) Location: <u>SW 1/4, SW 1/4, Sec. 36 T. 115 R. 6E</u> <u>5</u> miles <u>South</u> of <u>Natchez</u> (distance) (direction) (Nearest Town)	<u>Blue rock & sand</u>		<u>20</u> <u>60</u>
(3) Topography: <u>Flat</u> (Hilly) (Flat) (Level)	<u>Bottom</u>		<u>180</u>
(4) Purpose of Well: <u>Domestic</u> (Domestic Irrigation Municipal, Industrial, Other)			

Information upon completion of well:


- (1) Diameter 4 inches.
- (2) Total Depth 180' feet.
- (3) Water Level 40 feet below top of ground.
- (4) Cased to 23', Size 4"
- (5) Screen: Size , Length
- (6) Were any formations sealed against pollution?
 yes, no.

If YES depth of formation 20

Why Surface & sand

Drillers Remarks:

CODED

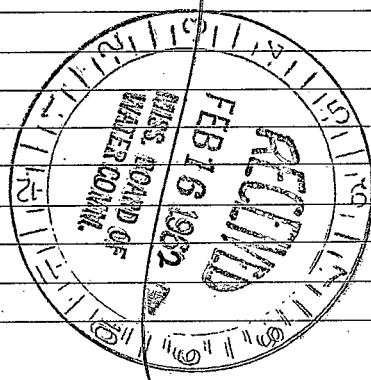

(Use Back Side)

Well No.

