

MONROE
A59
4-15-72

MISSISSIPPI
BOARD OF WATER COMMISSIONERS
416 North State Street
Jackson, Mississippi 39201

CODED

WATER WELL DRILLERS LOG

4-15 1972 date well completed
Herndon-Homan Well & Supply, Inc. firm name
Box 42
Monroe county well located
SHANNON, MISSISSIPPI 38868

LANDOWNER:

Andy Cox
Rt 2, Nettleton, Miss
(mailing address)

description of formations encountered

	from	to
Surface sand & clay	0	28
Blue clay	28	260
Sand	260	270
Bitum.	270	

WELL LOCATION:

sec. 22 T. 12 N. R. 6 E
S
3 1/2 miles SW of Nettleton
(distance) (direction) (nearest town)

WELL PURPOSE:

Home
(home, irrigation, municipal, industrial)

WELL COMPLETION DATA:

- diameter (inches) 5"
- total depth (feet) 400
- static water level (feet) 115 below top of ground.
- casing: Steel 30' (material) (depth)
5" (size) if telescope see back.
- screen: 10' (length) (depth to top)
(size) (material)
- pump: 1/2 (HP) 5 (yield gpm)
electric (type power)
- electric log: no (yes or no)

(organization running log)

- how well bottom plugged: open

DRILLERS REMARKS:


CODED

MAY 12 1972

MISS. Bd. of
WATER COMM.

If well telescopes please sketch and show depths.

GROUND LEVEL

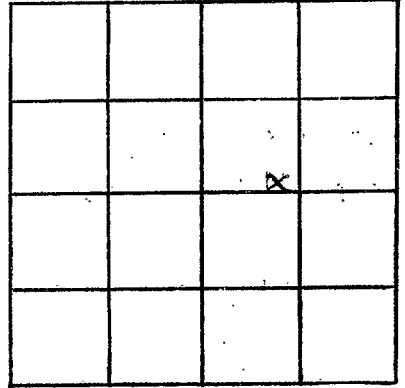

SECTION 22

Please indicate well location X.

ADDITIONAL INFORMATION

If more than one screen,
show locations of each on sketch.