

MONROE  
A61  
6-20-72

MISSISSIPPI  
BOARD OF WATER COMMISSIONERS  
416 North State Street  
Jackson, Mississippi 39201

WATER WELL DRILLERS LOG **CODED**

6/20 1972 Herman Homan Well & Supply, Inc. Monroe  
date well completed 170, Box 42 county well located

SHANNON, MISSISSIPPI 38668

LANDOWNER:

Odie Lee Jones  
Rt 1, Shannon, Miss.  
(mailing address)

description of formations encountered

	from	to
surface sand	0	27
Blue clay	27	200
Sand	200	340
Bottom	340	

WELL LOCATION:

sec. 6 T 12 N R 6 E  
S W  
5 miles SW of Nettleton  
(distance) (direction) (nearest town)

WELL PURPOSE:

Home  
(home, irrigation, municipal, industrial)

WELL COMPLETION DATA:

- (1) diameter (inches) 5"
- (2) total depth (feet) 340'
- (3) static water level (feet) 73 below above top of ground.
- (4) casing Steel, 30,  
(material) (depth),  
5" if telescope see back.  
(size)
- (5) screen ND,  
(length) (depth to top)  
(size) (material)
- (6) pump 3/4 5  
(HP) (yield gpm)  
electric  
(type power)
- (7) electric log ND  
(yes or no)  
(organization running log)
- (8) how well bottom plugged open

**CODED**


JUL 18 1972

DRILLERS REMARKS:

MISS. BD. OF  
WATER COM.

If well telescopes please sketch and show depths.

GROUND LEVEL

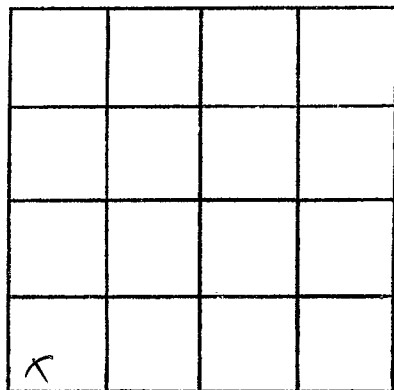

SECTION 6

Please indicate well location X.

ADDITIONAL INFORMATION

If more than one screen,  
show locations of each on sketch.